


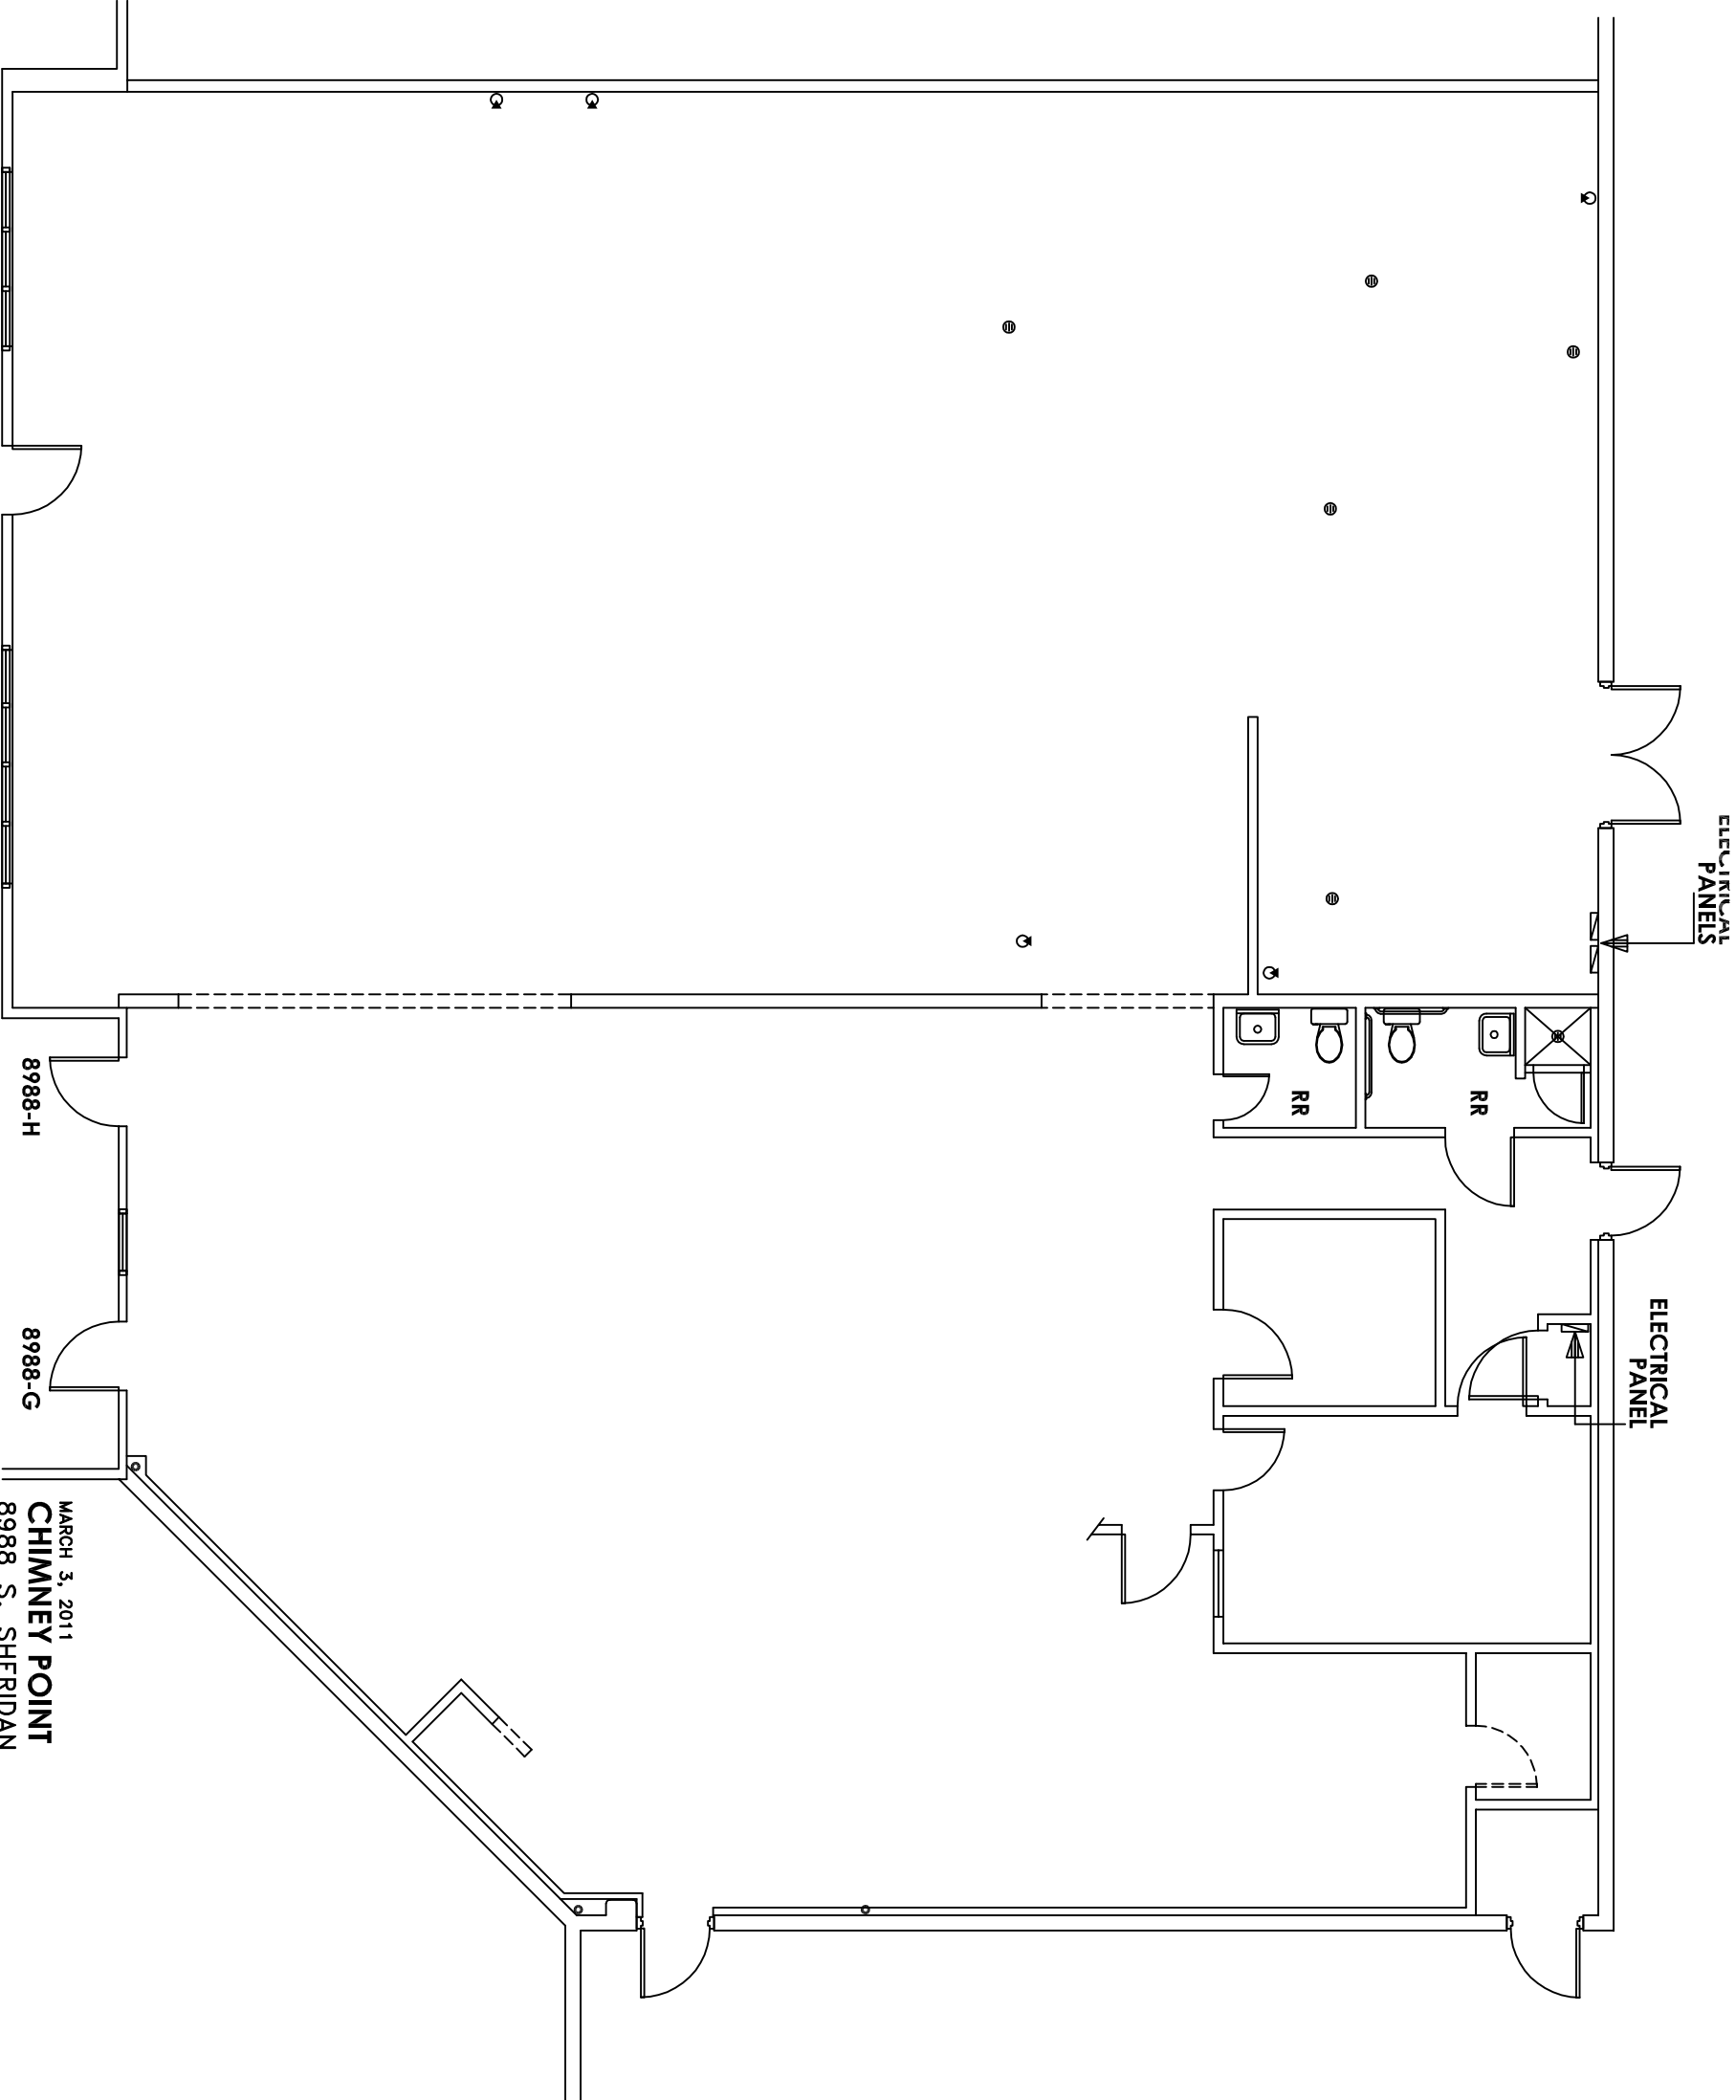

8988-J

8988-H

8988-G

MARCH 3, 2011
CHIMNEY POINT
8988 S. SHERIDAN
TULSA, OKLAHOMA 74137

THE SANDITEN COMPANIES
3314 EAST 51ST STREET
SUITE 200A
TULSA, OKLAHOMA 74135
(918)742-3315



NORTH

AS-BUILT FLOOR PLAN
1/8"=1'-0"