


FIRST FLOOR



7145 Industrial Dr. El Paso, TX 79925

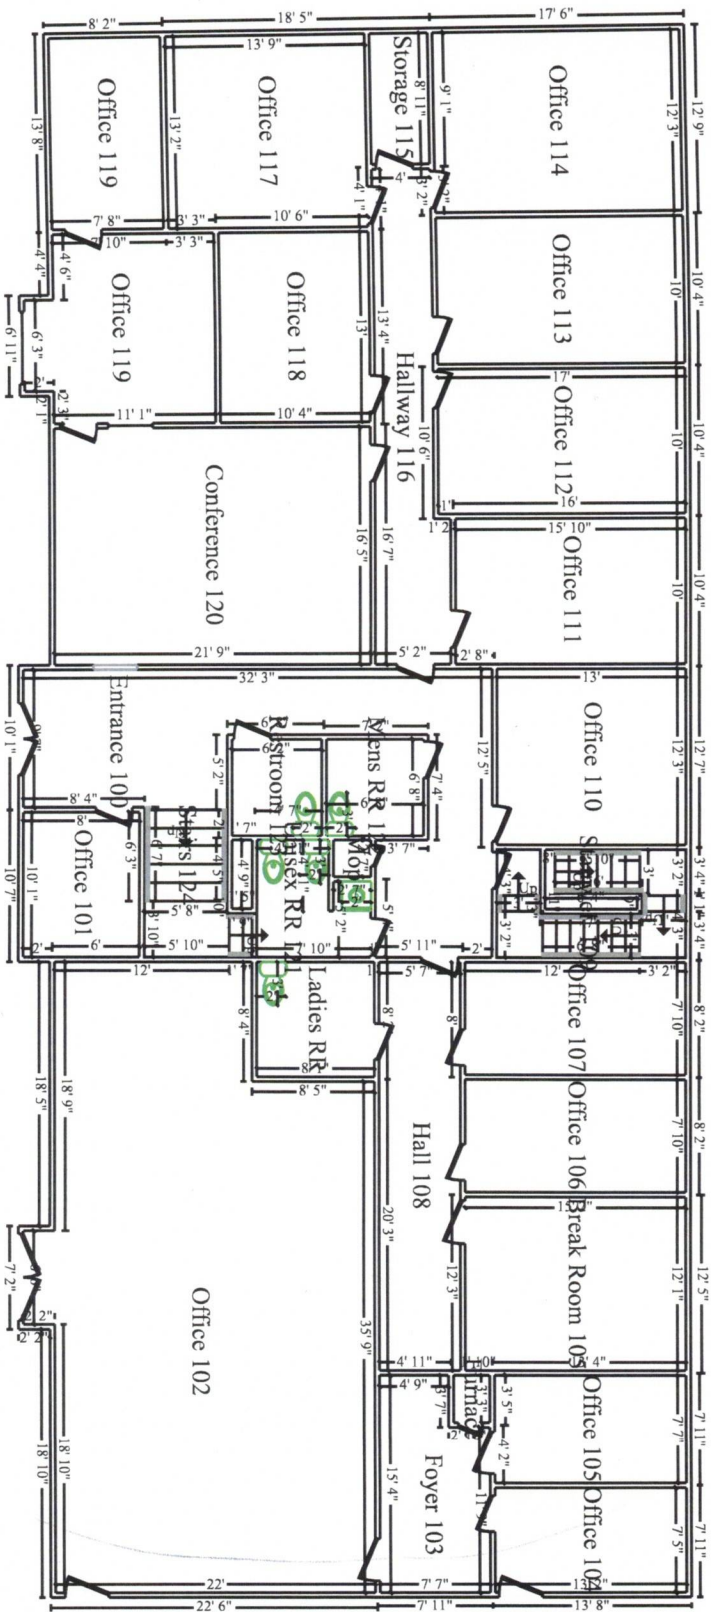

Main Level

