


AS-BUILT FLOOR PLAN

15,000 RSF



3326 US HIGHWAY 6, SUGAR LAND, TEXAS

DATE: 9-24-2019
need verify

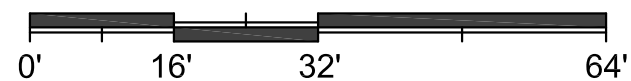

Creating Communities in Our Properties™

DESIGN
DRAWING
NOT FOR
PERMIT OR
CONSTRUCTION