



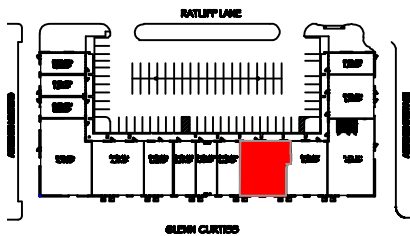

Z PROJECTS, LLC
1413 JACKSON RD.
KELLER, TX 76262
817.875.1806
www.linkedin.com/in/davezobrtst

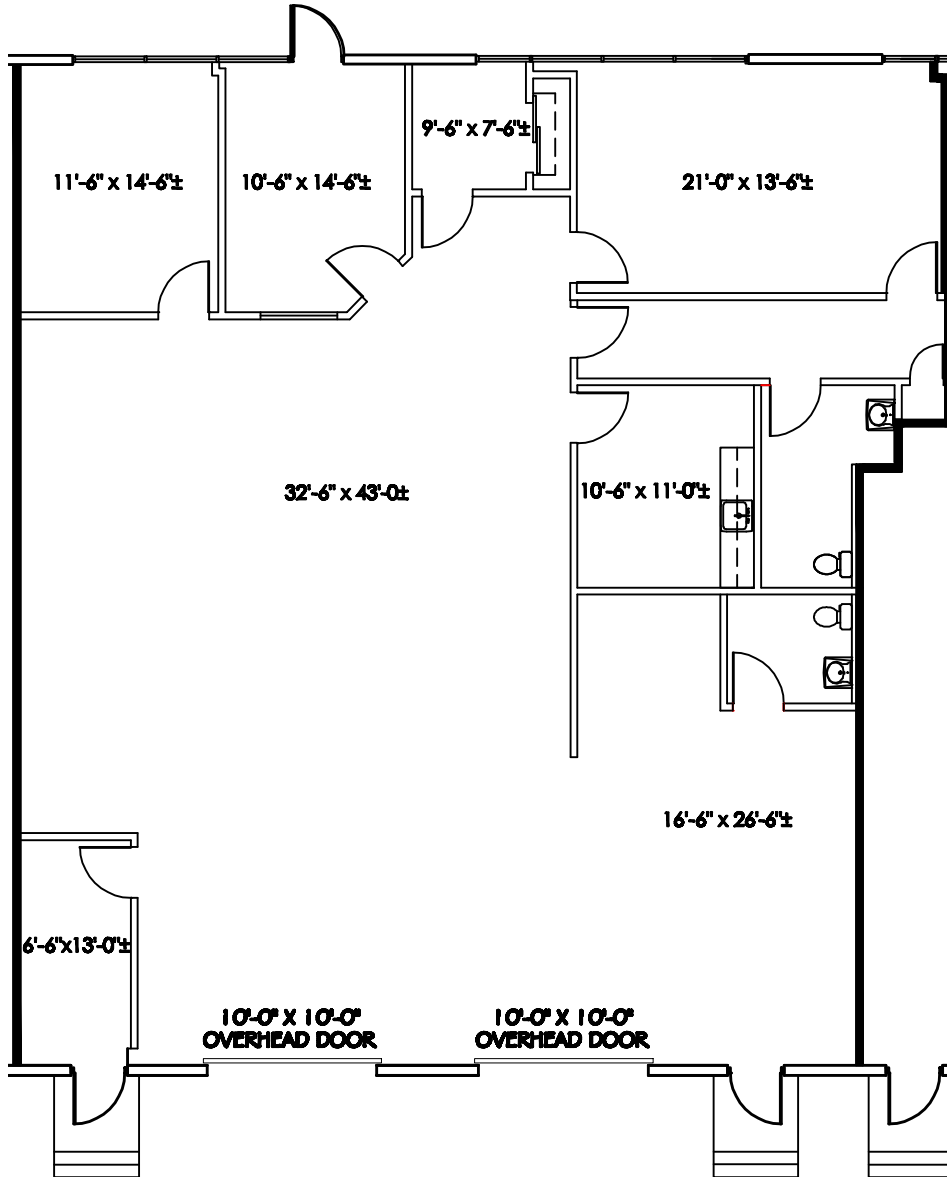

ROBERT B. POWELL, CCIM
POWELL REALTY ADVISORS, LLC.
214-908-3488
Robert.Powell@PowellRealtyAdvisors.com

AIRPORT PLAZA
SUITE 108 | 3,270 SF
4500 RATLIFF | ADDISON, TX 75001

AS BUILT

11.05.2025