


**SUITE 230:**  
**± 1,577 RSF**

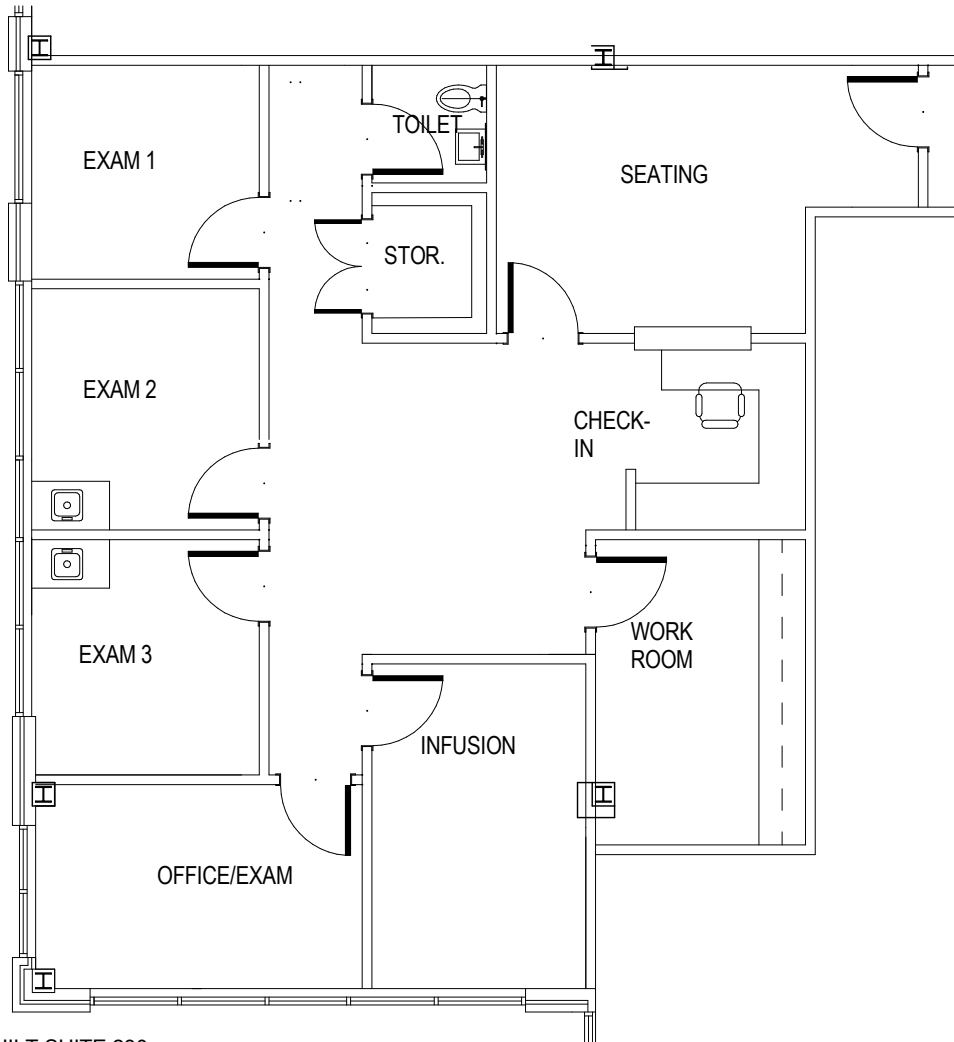

① AS-BUILT SUITE 230  
3/16" = 1'-0" ON 11"x17"