
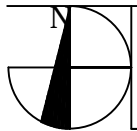


7550 East Greenway Road
Scottsdale . Arizona
Suite 100 - 5,104 SF

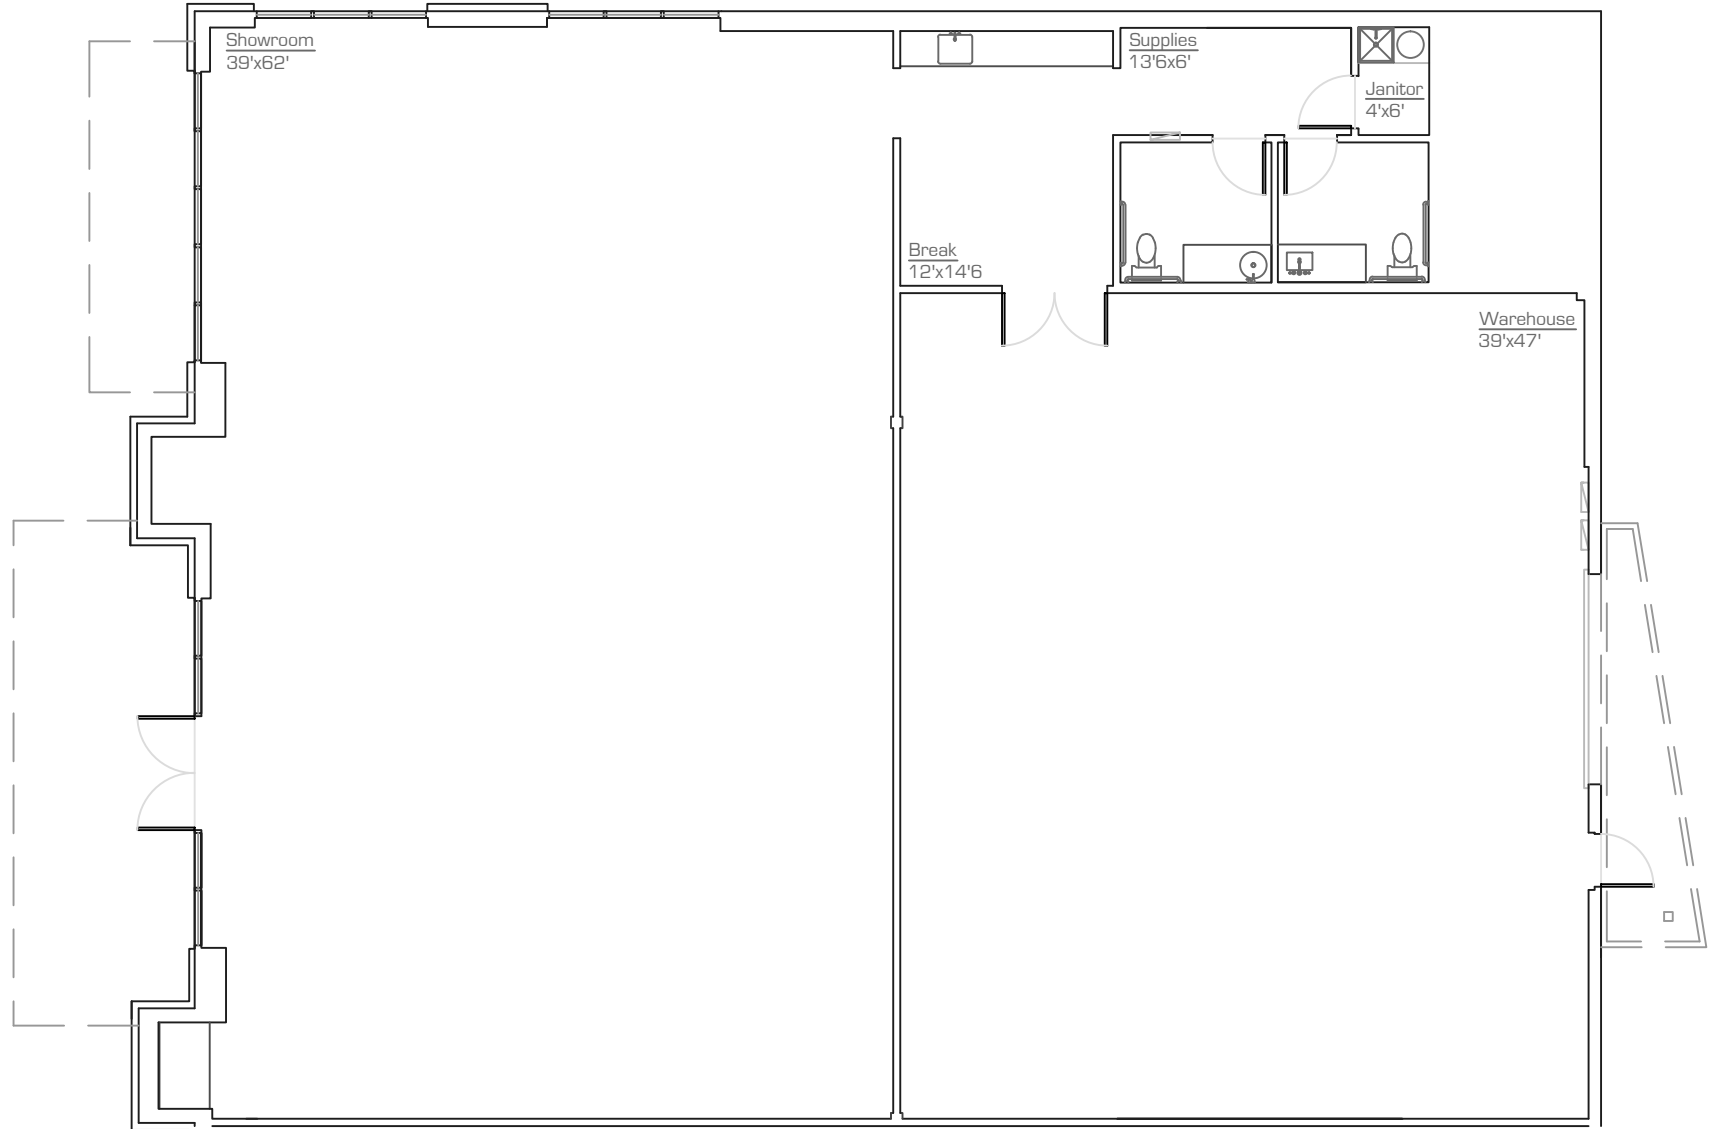

Space Plan A
scale: nts
4.August.2025

*All dimensions are approximate at ± 3"
*All information is of general nature

precisionDIMENSIONS

as-built & survey
602.790.6412

