


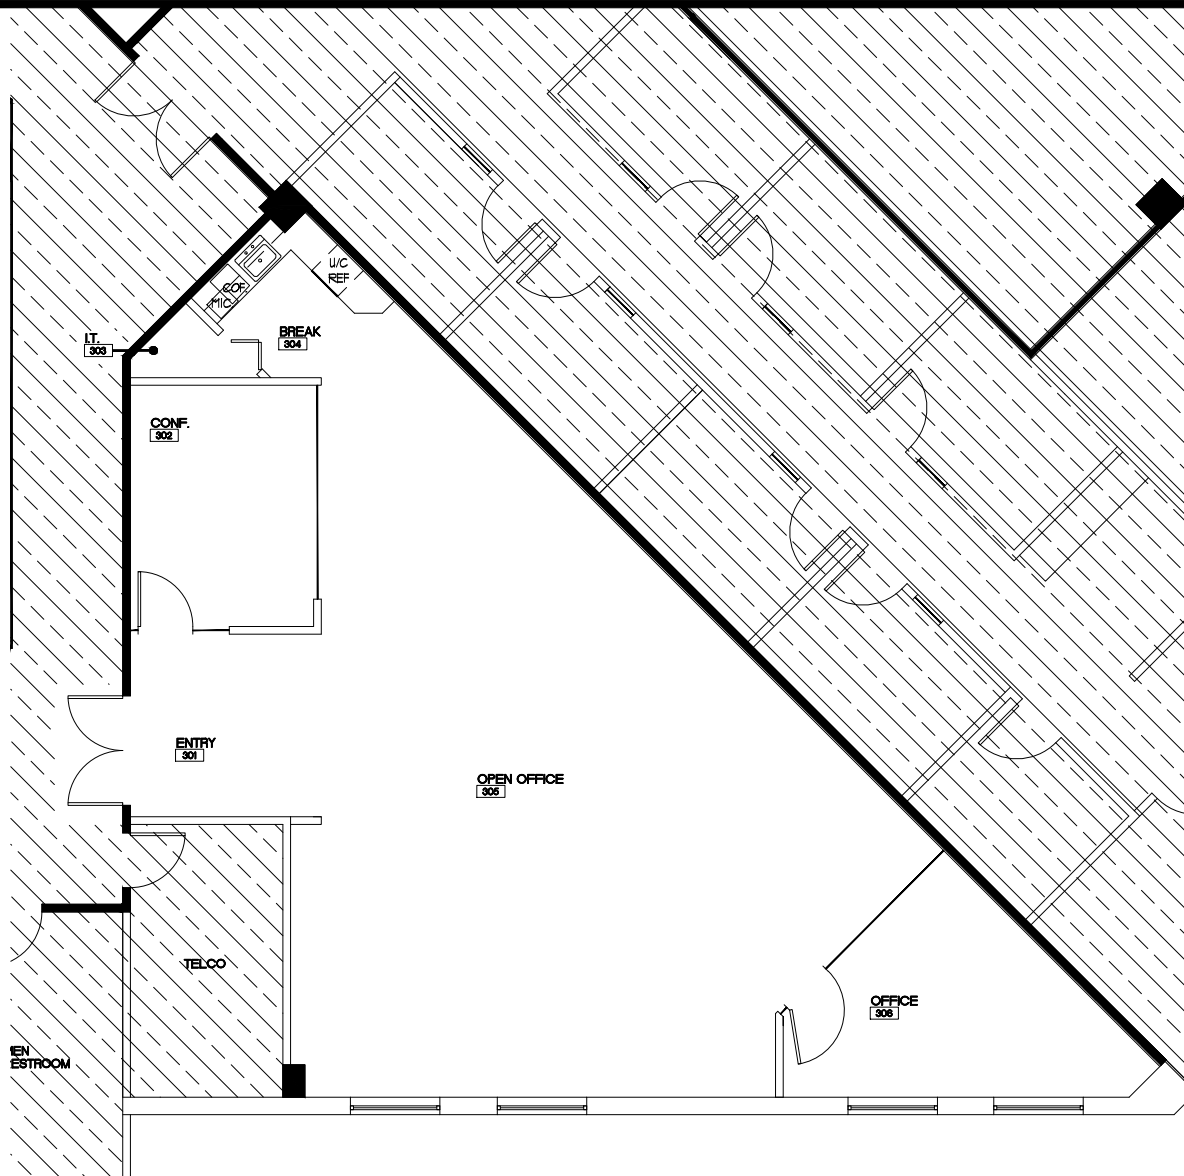

TRIESCHMANN DUMALA ARCHITECTURAL GROUP

ARCHITECTURE | PLANNING | INTERIORS

6451 East Rogers Circle | Suite 9 | Boca Raton | FL 33487
P: 561.981.8000 F: 561.981.8916

AA26002244

AA26002252

www.tdarchgroup.com

SUITE 380

6111 BROKEN SOUND PARKWAY
AS-BUILT PLAN

NOTE: SPACE NEEDS TO BE REVERIFIED DUE TO SITE CONDITIONS
NOTE: FURNITURE FOR ILLUSTRATION PURPOSES ONLY
NOTE: ROOM SIZES ARE APPROXIMATE

SCALE : NTS
DRAWN : KLS
8 . 1 1 . 2 6