


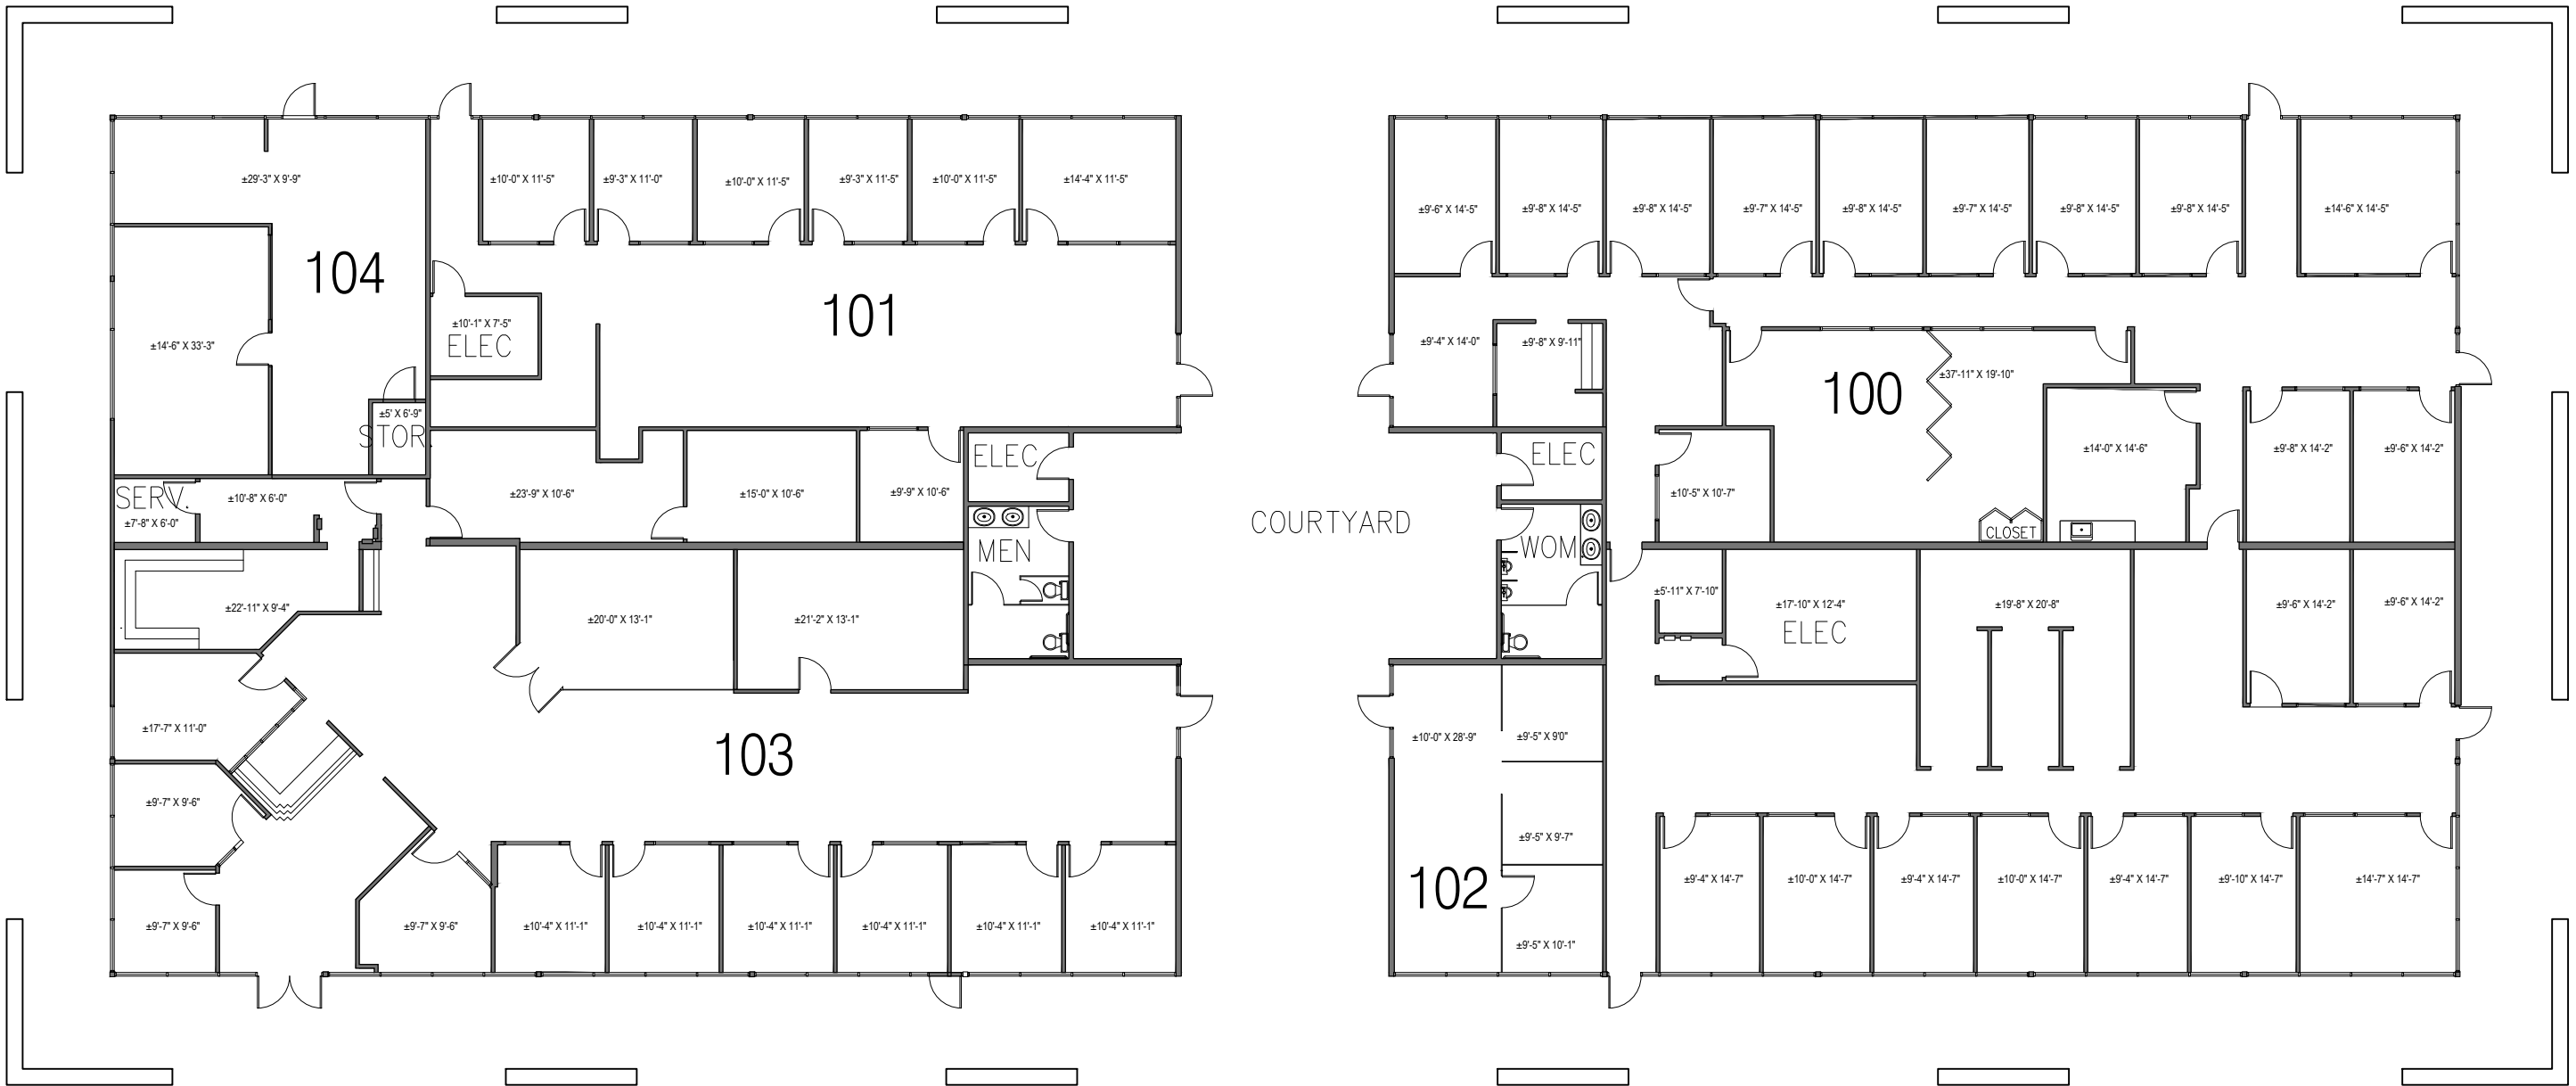

3820 Del Amo Blvd, Suite 336, Torrance, CA 90503
Office 310 828 2500

Interiors

SUBJECT:

As-Built Plan

PROJECT NAME:

950 Hampshire Rd
Ground Floor
Westlake Village, CA 91361

DATE: 07/07/2026 SCALE: 1/16" = 1'-0"

REVISED BY: C. Kings

JOB NUMBER: 26.4020.00

FILE:

SKETCH NUMBER:
SK 01