


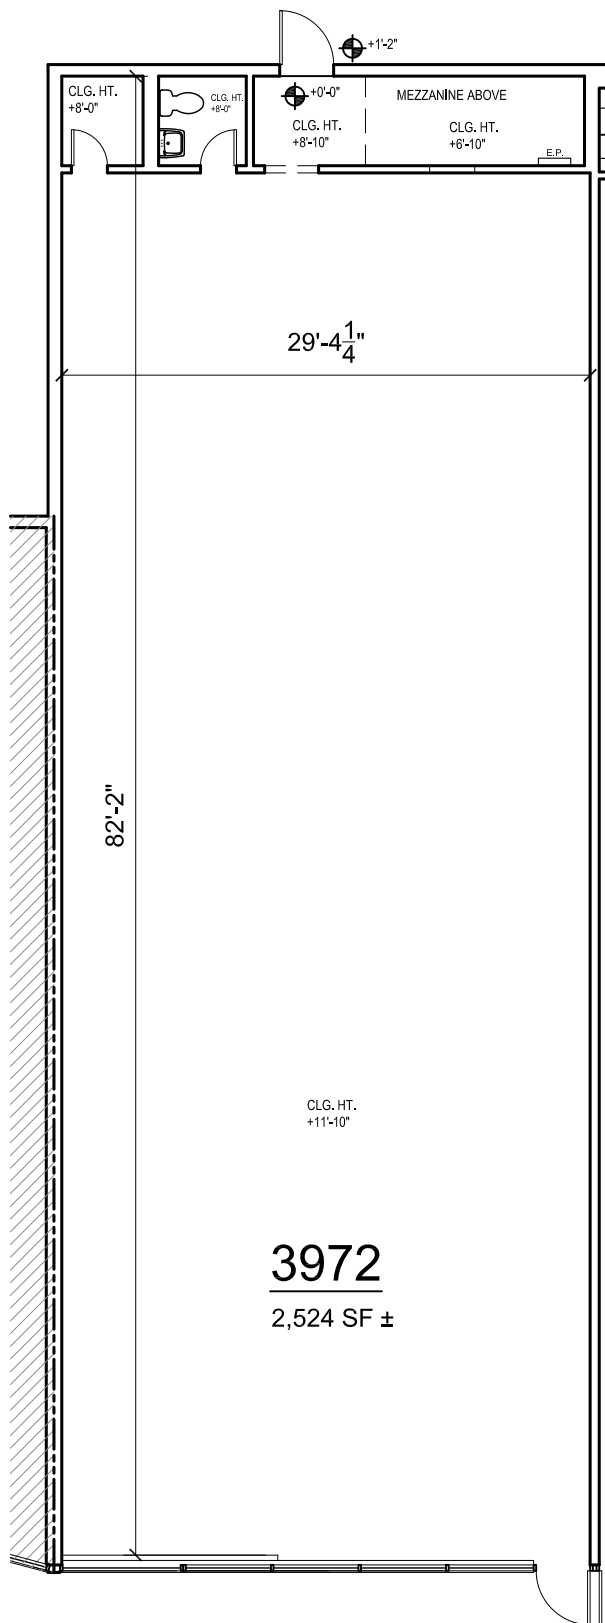

TRUE NORTH

ALL Architecture, LLC

INFO@ALLARCHLLC.COM

DATE: 04/05/26

PROJ. NO. 26020

3972 LAWRENCEVILLE HWY
TUCKER, GA 30084

AS-BUILT FLOOR PLAN



SHEET
1