


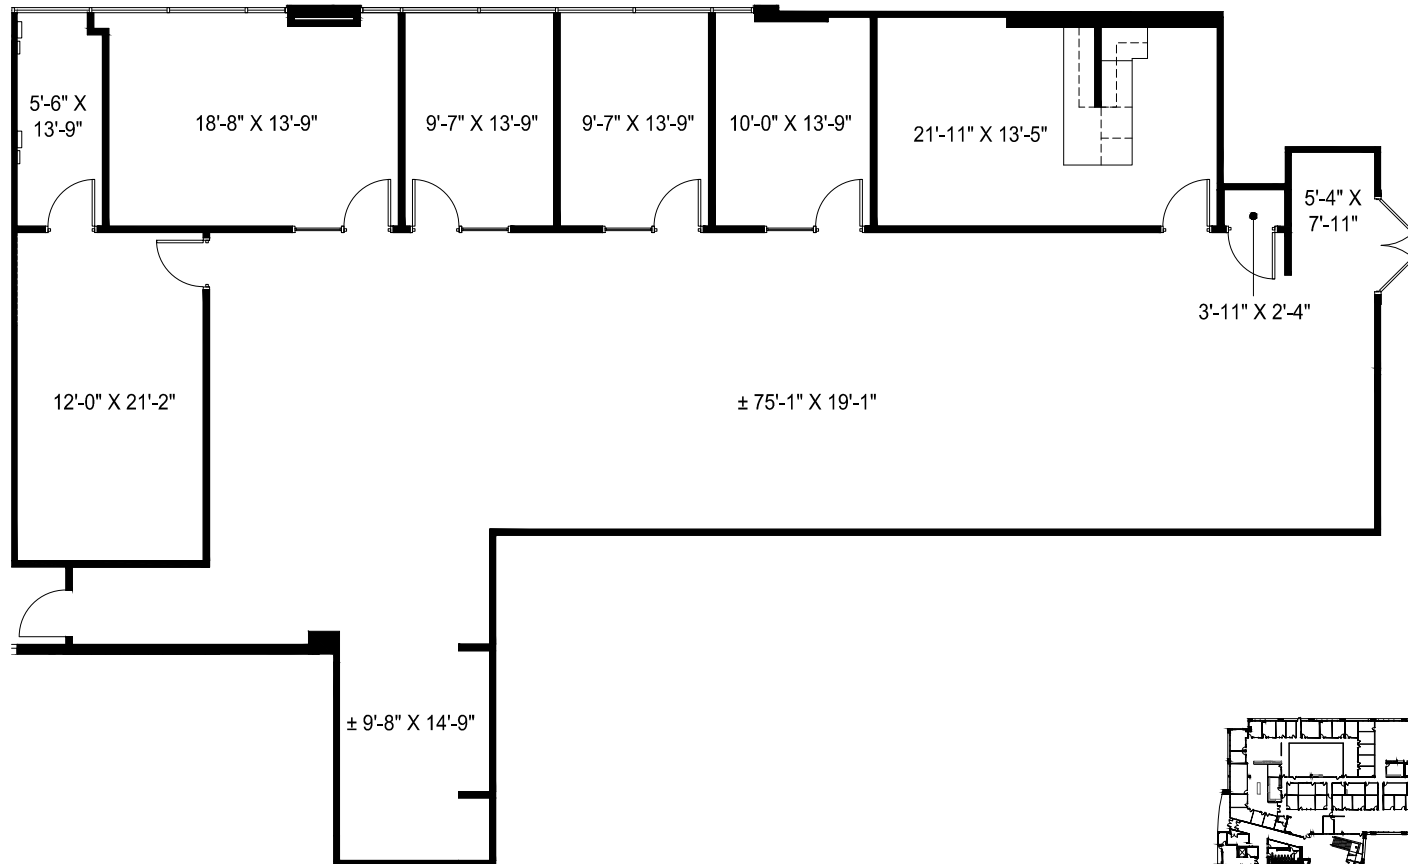

FLOOR 01

NORTH

ALL DIMENSIONS ARE APPROXIMATE AND SUBJECT TO NOMINAL VARIANCE.

NEWMARK

WILLOW BEND OFFICE CENTER
PLANO, TEXAS

AS-BUILT PLAN
SUITE 110

rsf: 3,558

scale: N.T.S.

date: 06.30.2026



1201 main street
suite 1370
dallas, texas 75202
214.420.4646