


*as-built conditions*



*proposed layout*

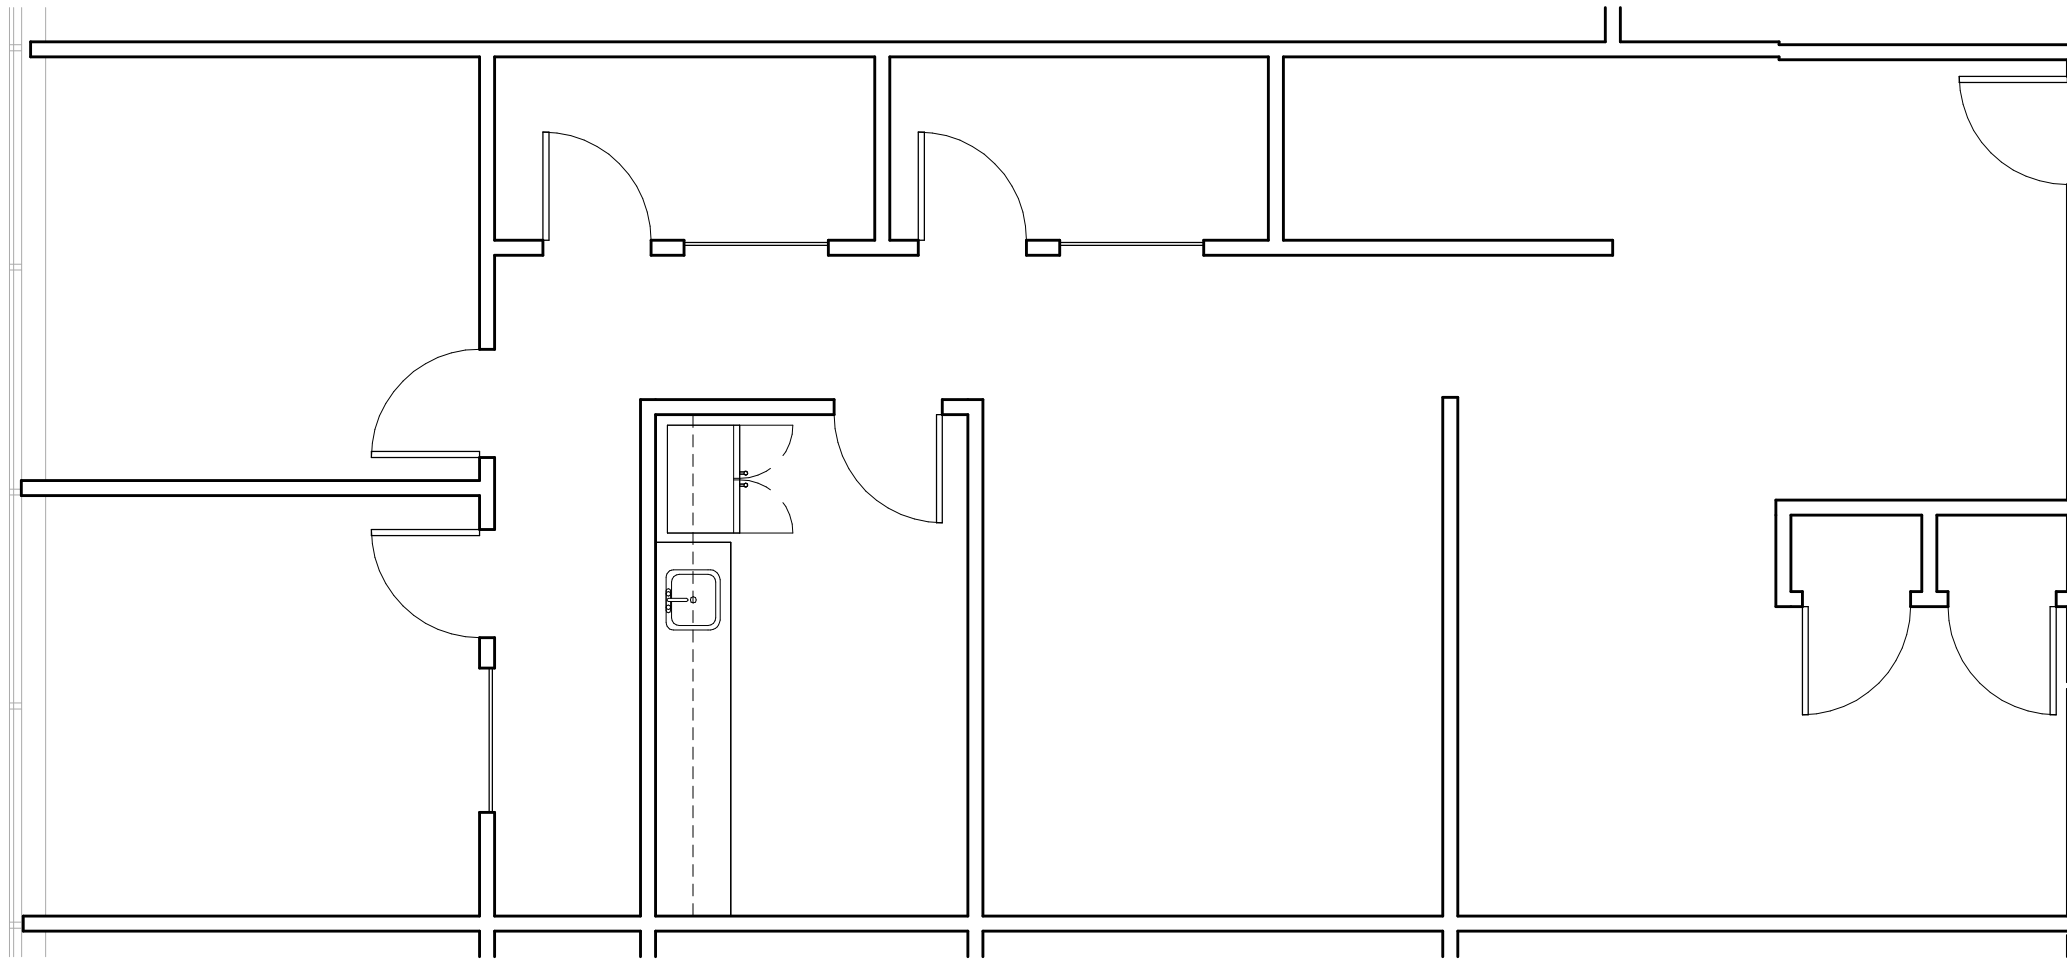