

Disclaimer:
As-Builts Drawn by BuildingPoint SouthEast
These drawings are not intended to represent in detail the exact location, type of component nor manner of construction. BuildingPoint SouthEast will not be responsible for any errors or omissions which have been incorporated into the record drawings.

LINDEN COTTON MILL

217 DEPOT ST.
DAVIDSON, NC 28036

[illegible]

COPYRIGHT:
BUILDINGPOINT SOUTHEAST
PRINTING DATE: 5/10/2019
SCALE: 3/32" = 1'-0"


DRAWING NAME

MAIN LEVEL FLOOR PLAN

DRAWING NUMBER

A100

Red = Leased
White = Available

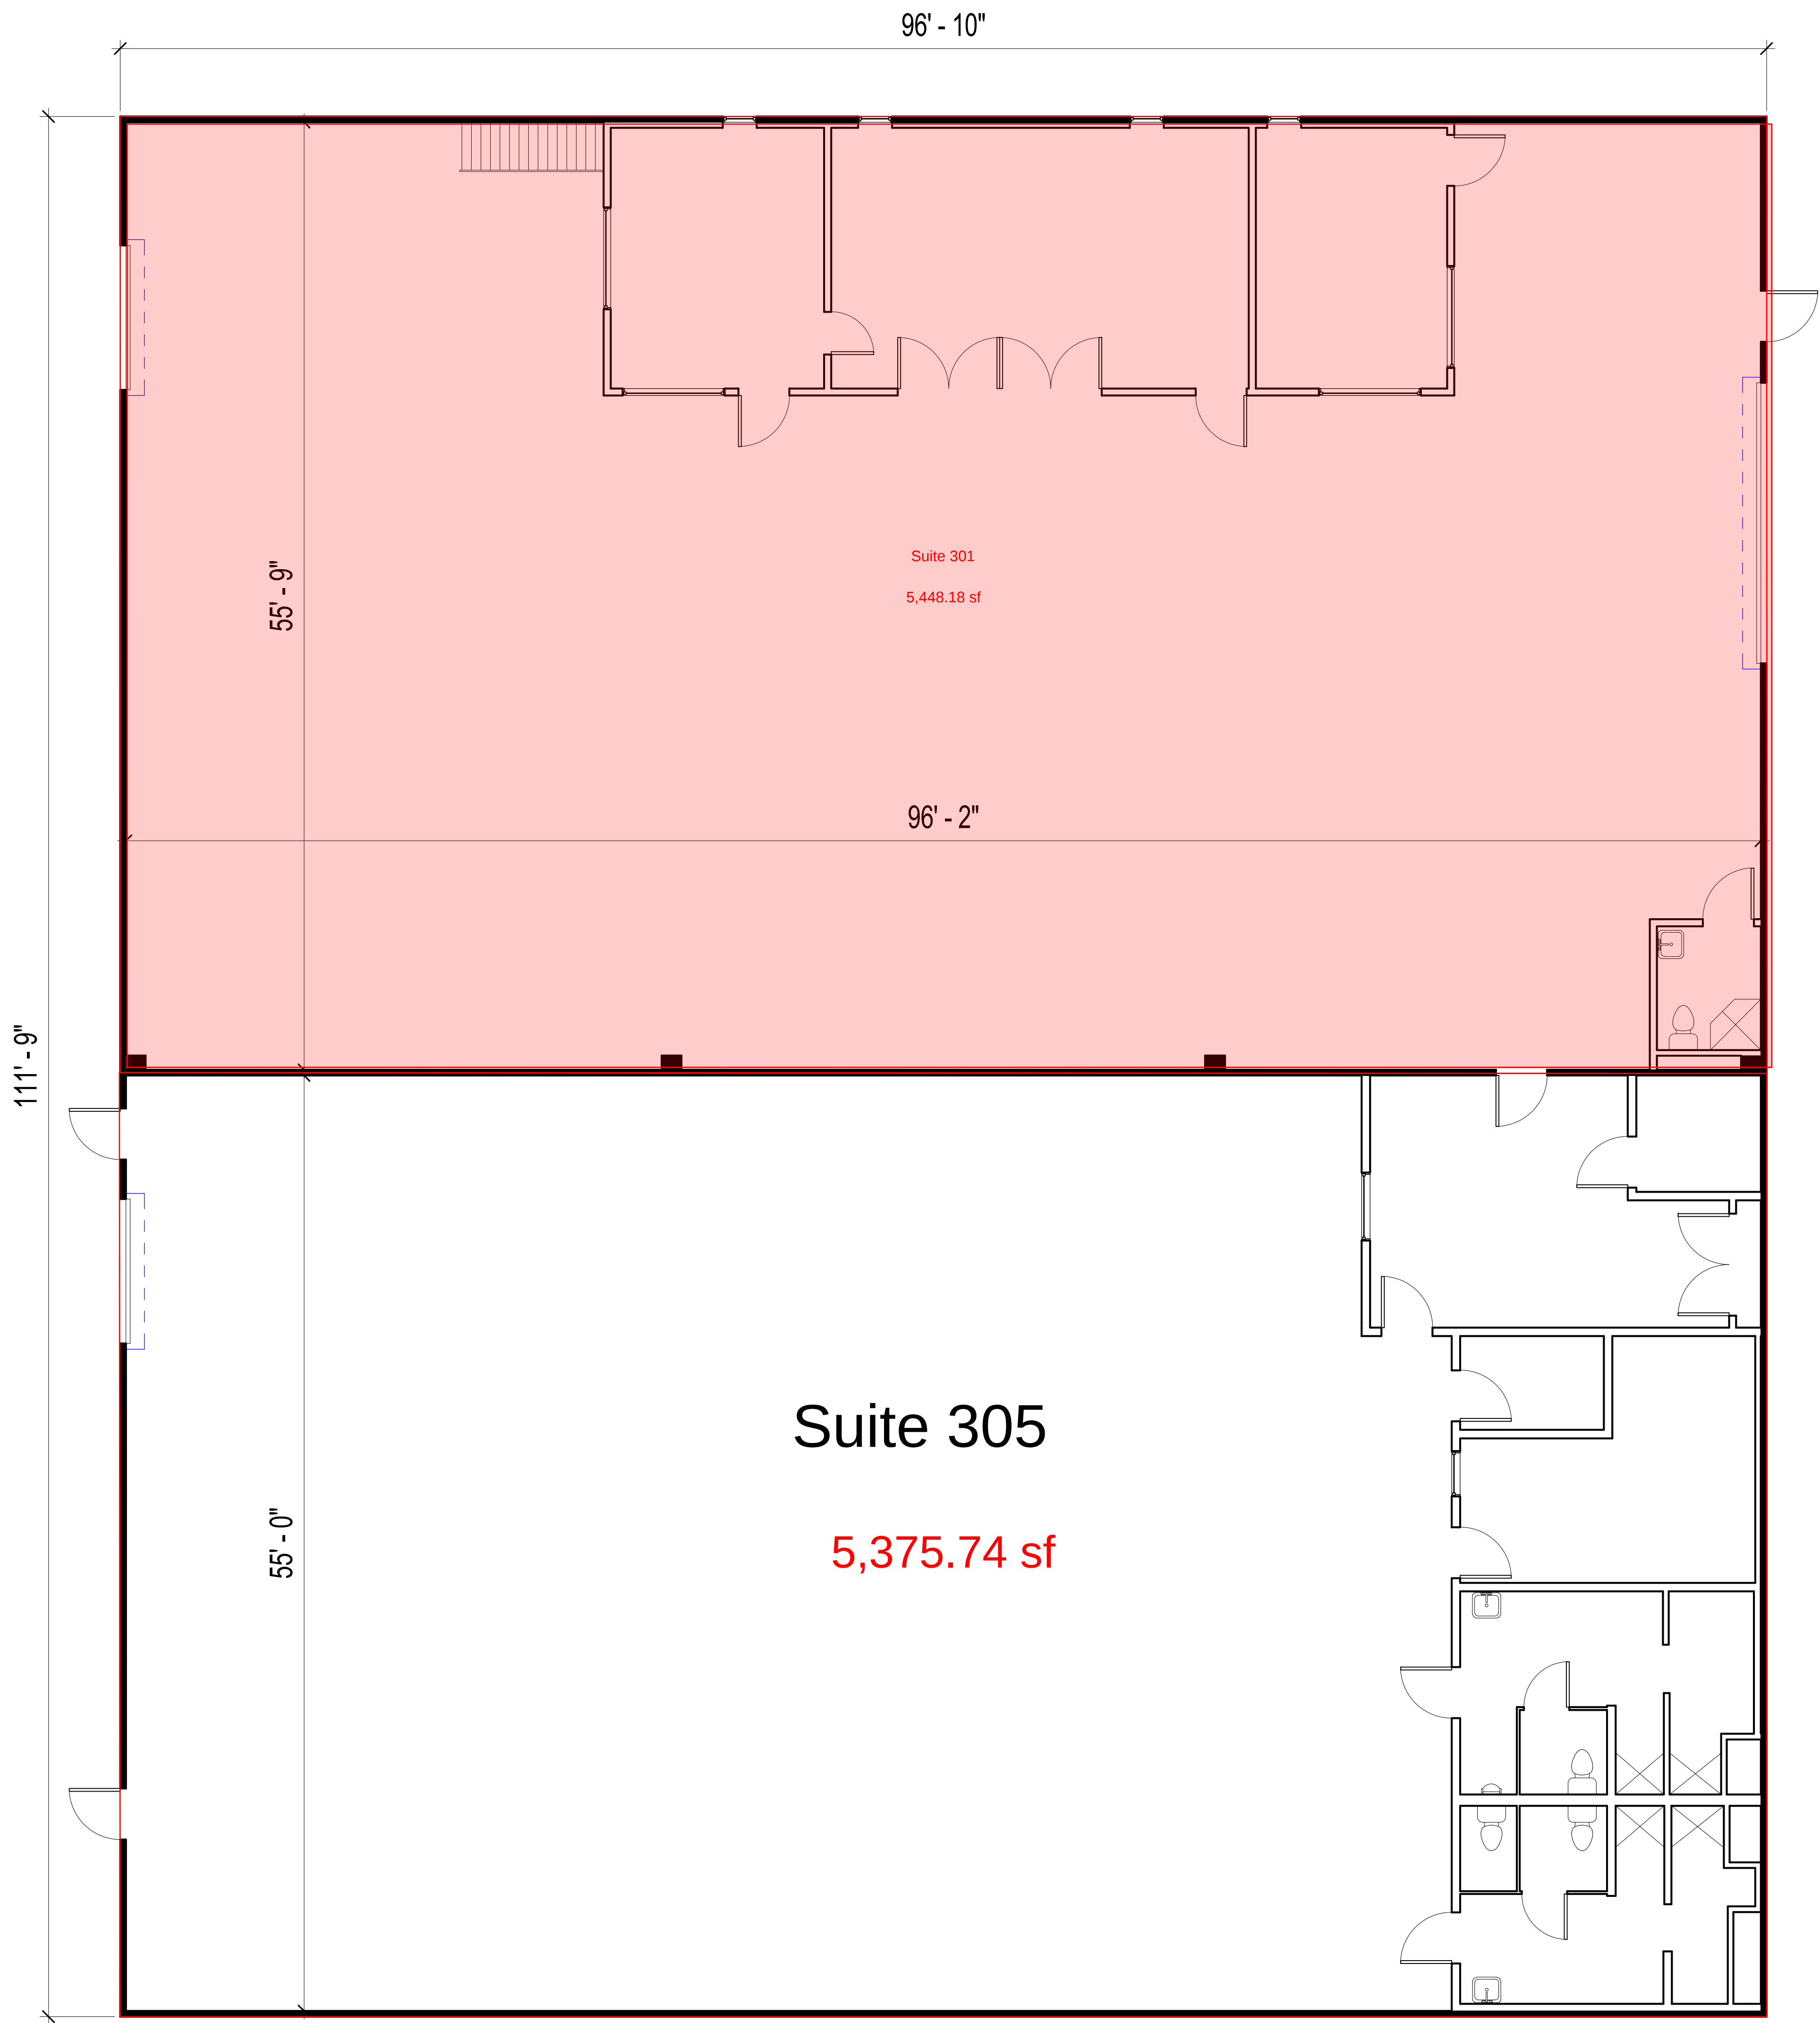

Disclaimer:
As-Built Drawn by BuildingPoint SouthEast
These drawings are not intended to represent in detail
the exact location, type of component nor manner of
construction. BuildingPoint SouthEast will not be
responsible for any errors or omissions which have
been incorporated into the record drawings.

DEPOT STREET TILT UP
BUILDING
301 & 305 DEPOT ST.
DAVIDSON, NC 28036

REVISIONS		
No.	Date	Description



COPYRIGHT:
BUILDINGPOINT SOUTHEAST
PRINTING DATE: 5/13/2019
SCALE: 3/16" = 1'-0"

DRAWING NAME
MAIN LEVEL
FLOOR PLAN

DRAWING NUMBER
A100