


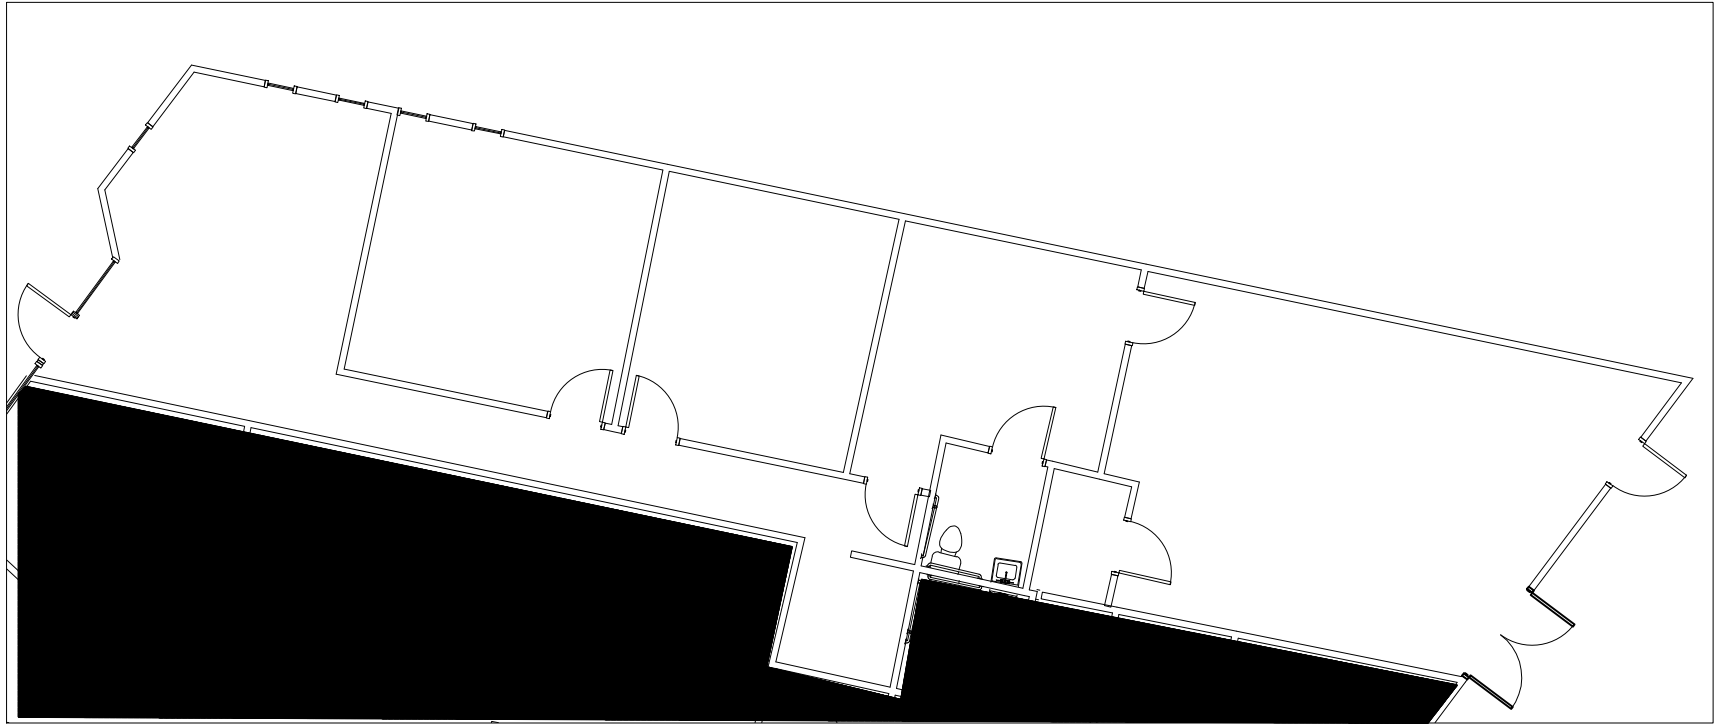

SCALE: N.T.S.

AS-BUILT PLAN SUITE 224

2660 HOLCOMB BRIDGE ROAD
ROSWELL, GA 30022

6.4.26

ARCHITECTURAL DESIGN INNOVATIONS

ADI, Inc.