
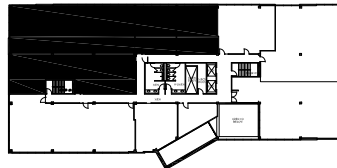


GRAYMARK OFFICE BUILDING

16801 Addison Road, Addison, Texas

SUITE 240
6,661 RSF

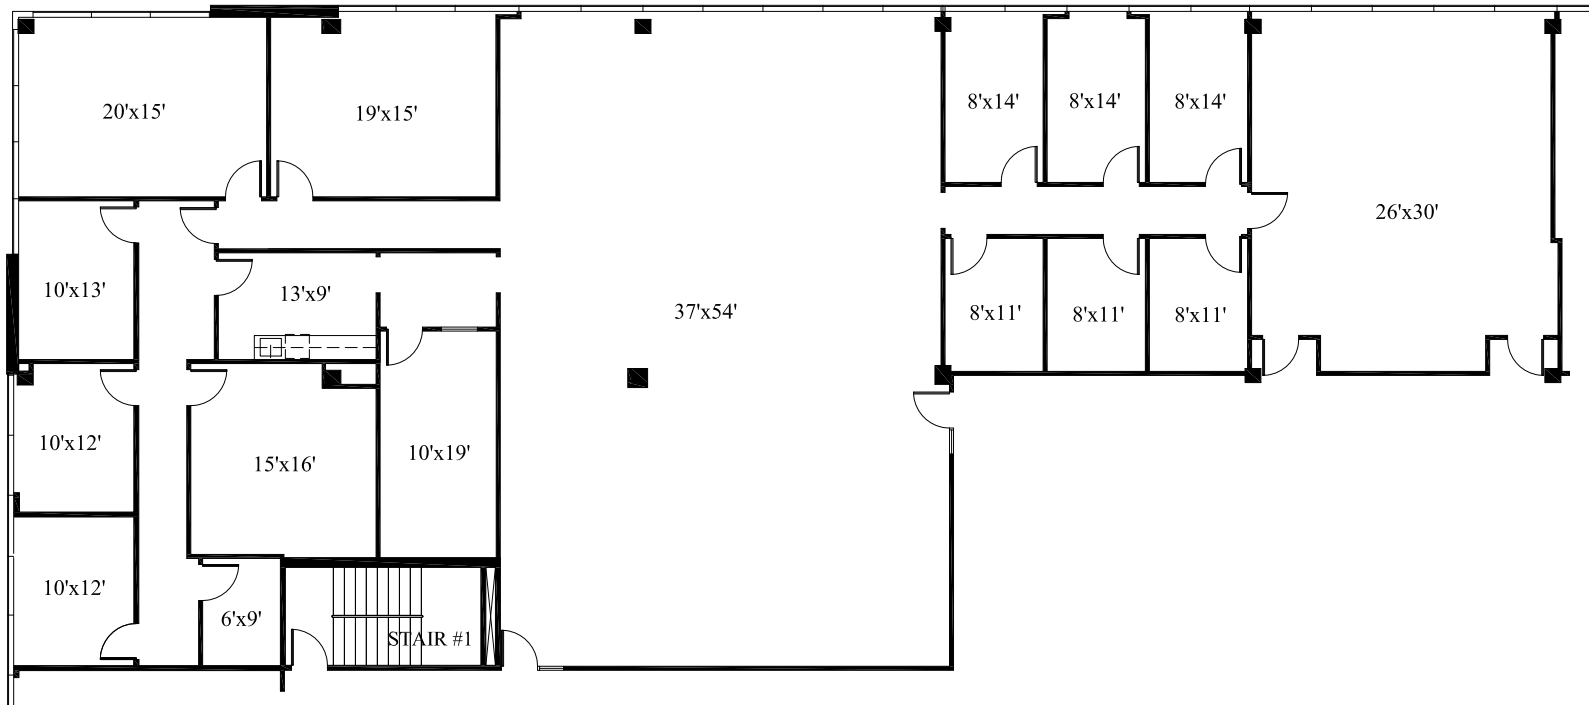

2ND FLOOR

Scale: 1/16"=1'-0"

All dimensions and square footages are approximate.

January 19, 2023

