


Suite A-201-205 | 3,798 SF

AS BUILT FLOOR PLAN

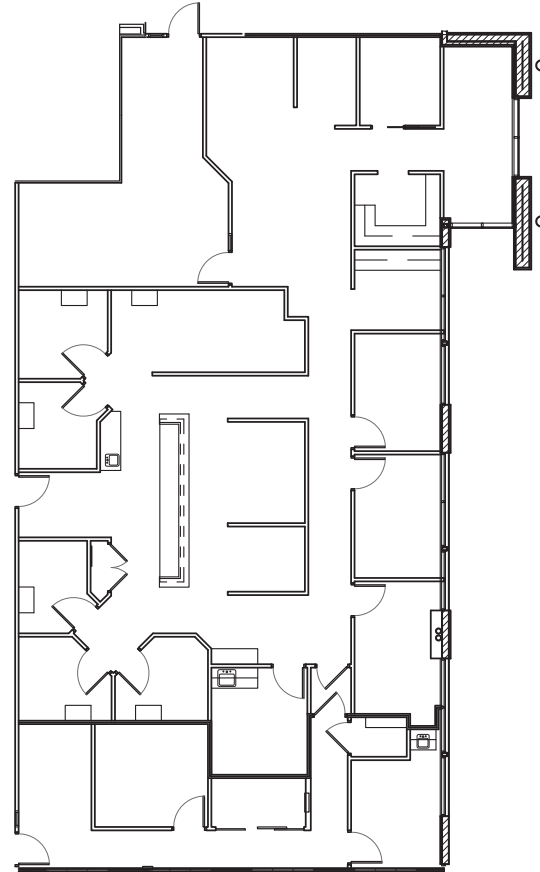

OWNED BY



LEASING BY

Rachael Thompson

602.513.5122

rachael.thompson@kidder.com

Perry Gabuzzi, CCIM


602.513.5116

perry.gabuzzi@kidder.com



Suite A-201-205 | 3,798 SF

TEST FIT FLOOR PLAN

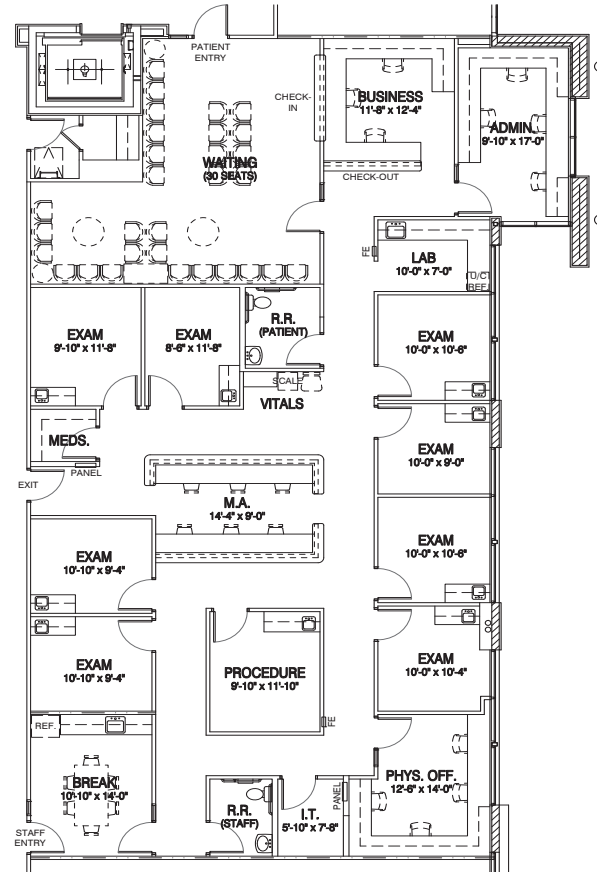

OWNED BY



LEASING BY


Rachael Thompson
602.513.5122
rachael.thompson@kidder.com

Perry Gabuzzi, CCIM
602.513.5116
perry.gabuzzi@kidder.com



Suite B-221 | 4,580 SF

AS BUILT FLOOR PLAN

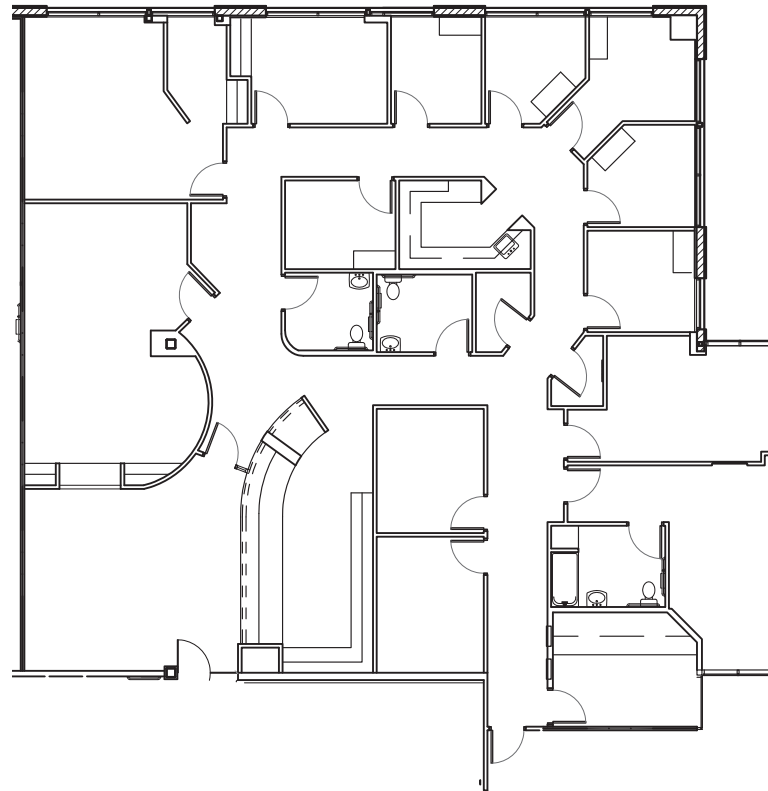

OWNED BY



LEASING BY

Rachael Thompson

602.513.5122

rachael.thompson@kidder.com

Perry Gabuzzi, CCIM


602.513.5116

perry.gabuzzi@kidder.com



Suite B-221 | 4,580 SF

TEST FIT FLOOR PLAN

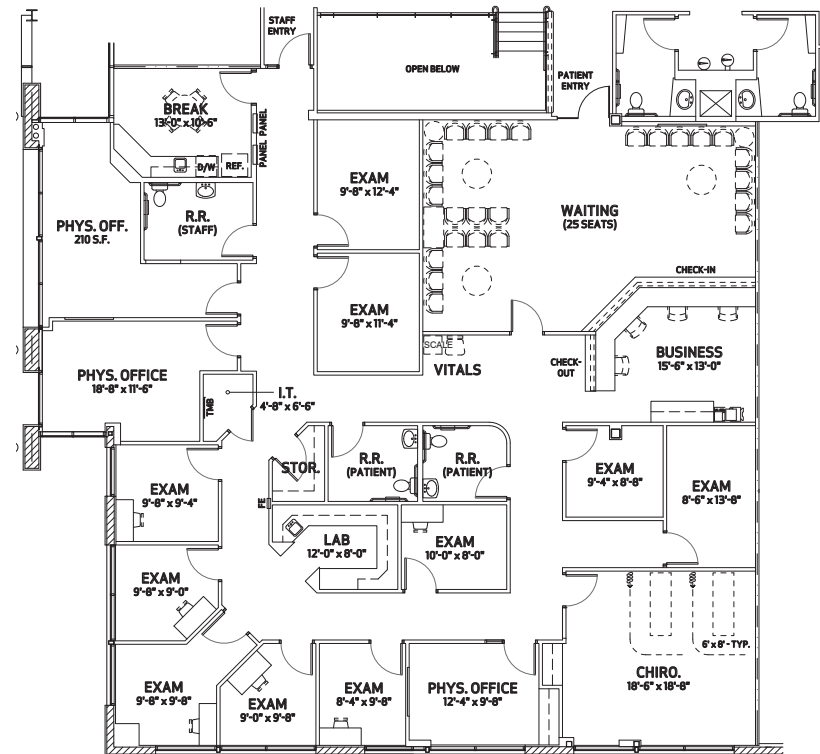

OWNED BY



LEASING BY

Rachael Thompson
602.513.5122
rachael.thompson@kidder.com

Perry Gabuzzi, CCIM
602.513.5116
perry.gabuzzi@kidder.com

