

GRANITE
VALLEY
MEDICAL
OFFICE


Floor 2

Suite 222

AS-BUILT

1,589 SF

AVAILABLE

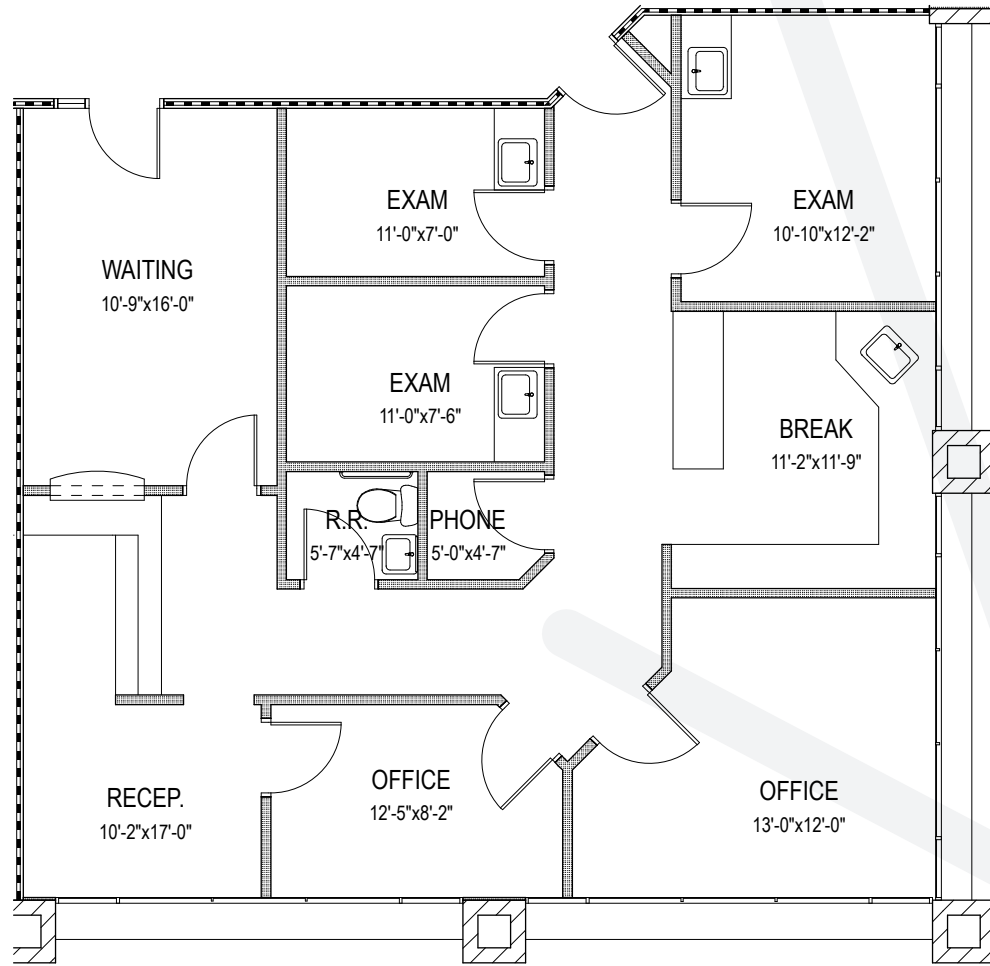

RACHAEL THOMPSON
Senior Vice President
602.513.5122
rachael.thompson@kidder.com

PERRY GABUZZI, CCIM
Senior Vice President
602.513.5116
perry.gabuzzi@kidder.com