

2ND STORY




CALVARIO FUNERAL CHAPEL
111 NORTHSIDE DRIVE
FORT WORTH, TEXAS 76164

AS-BUILT FOR COO
DIMENSIONED FLOOR PLAN

AREA TABULATIONS:

GROUND FLOOR (MAIN)	8548 SF
2ND FLOOR (MAIN)	4340 SF
CHAPEL	3700 SF
TOTAL CONDITIONED SPACE	16,588 SF

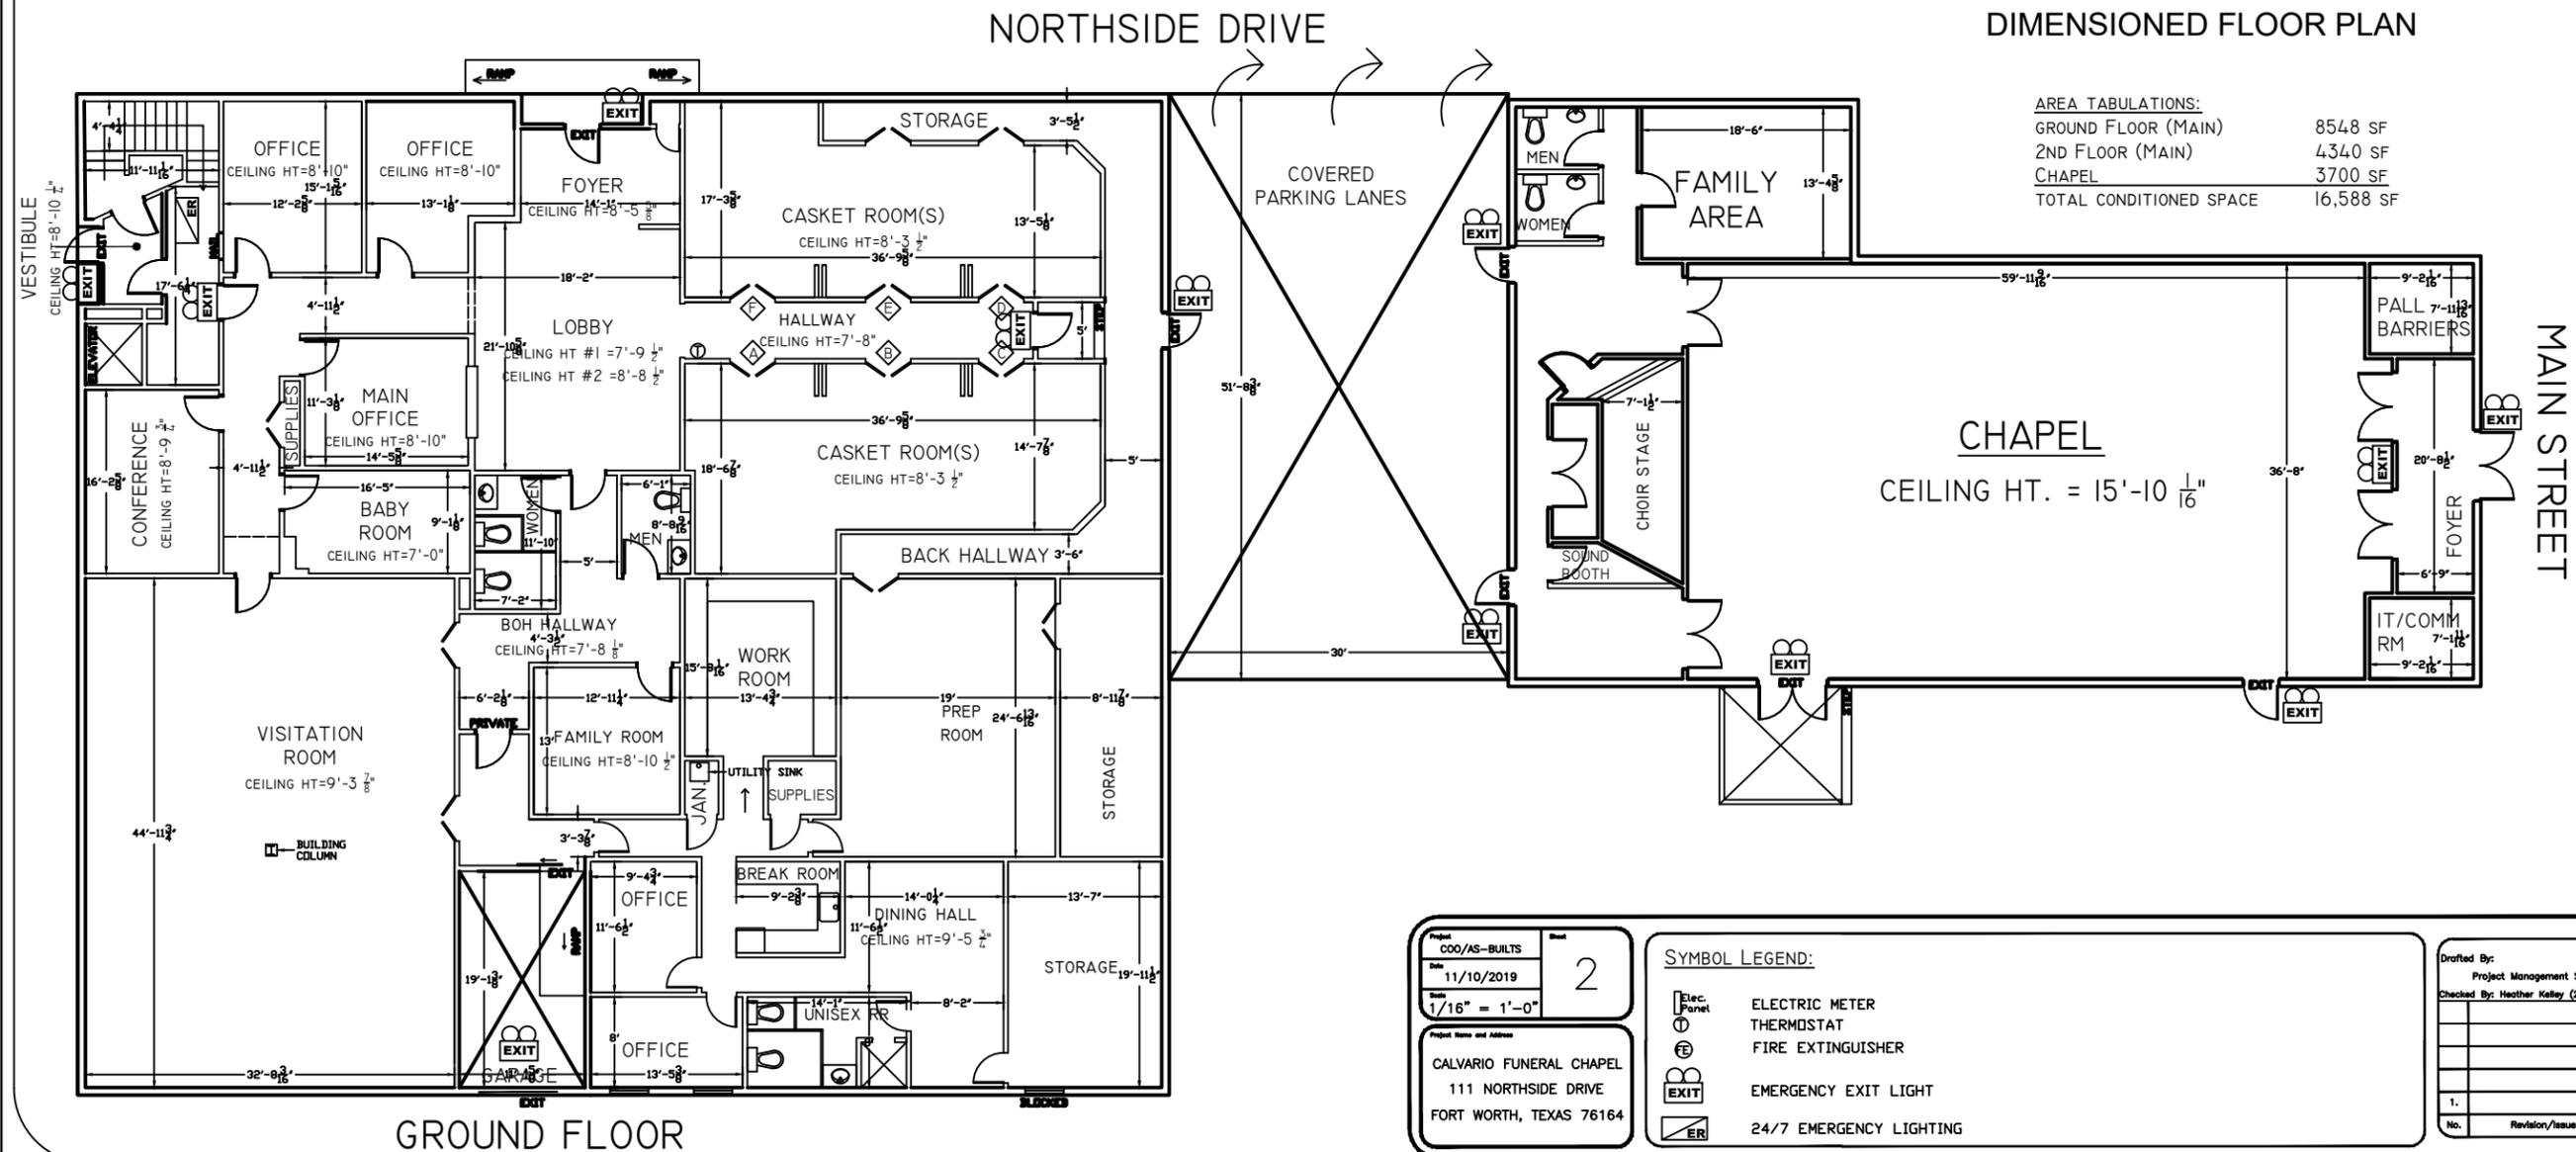

Project	COO/AS-BUILTS	Sheet	2
Date	11/10/2019		
Scale	1/16" = 1'-0"		
Project Name and Address	CALVARIO FUNERAL CHAPEL 111 NORTHSIDE DRIVE FORT WORTH, TEXAS 76164		

SYMBOL LEGEND:

	ELECTRIC METER
	THERMOSTAT
	FIRE EXTINGUISHER
	EMERGENCY EXIT LIGHT
	24/7 EMERGENCY LIGHTING

Drafted By: Project Management Services
Checked By: Heather Kelley (214) 417-4910

No.	Revision/Issue	Date
1.		