


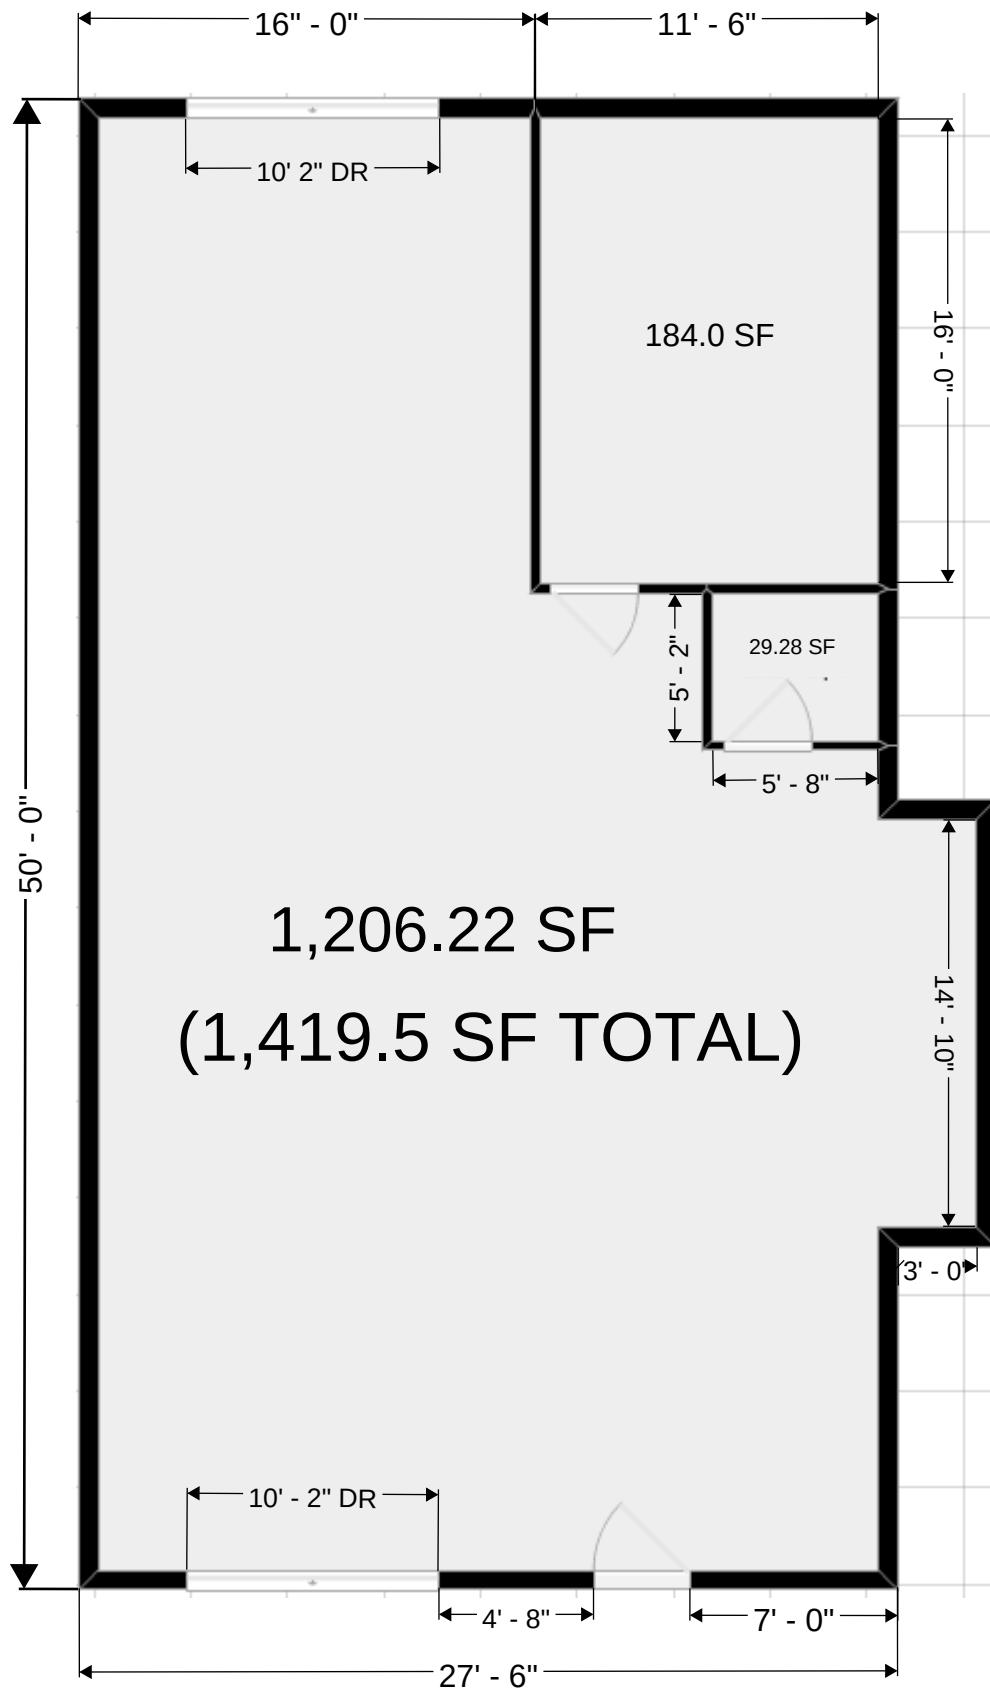

AS BUILT -SUITE

355-1/2 W. Morthland Drive

VALPARAISO, IN. 46383

REVISIONS BY