


1800 SANDY PLAINS INDUSTRIAL PARKWAY
BUILDING 300 - SUITE 310

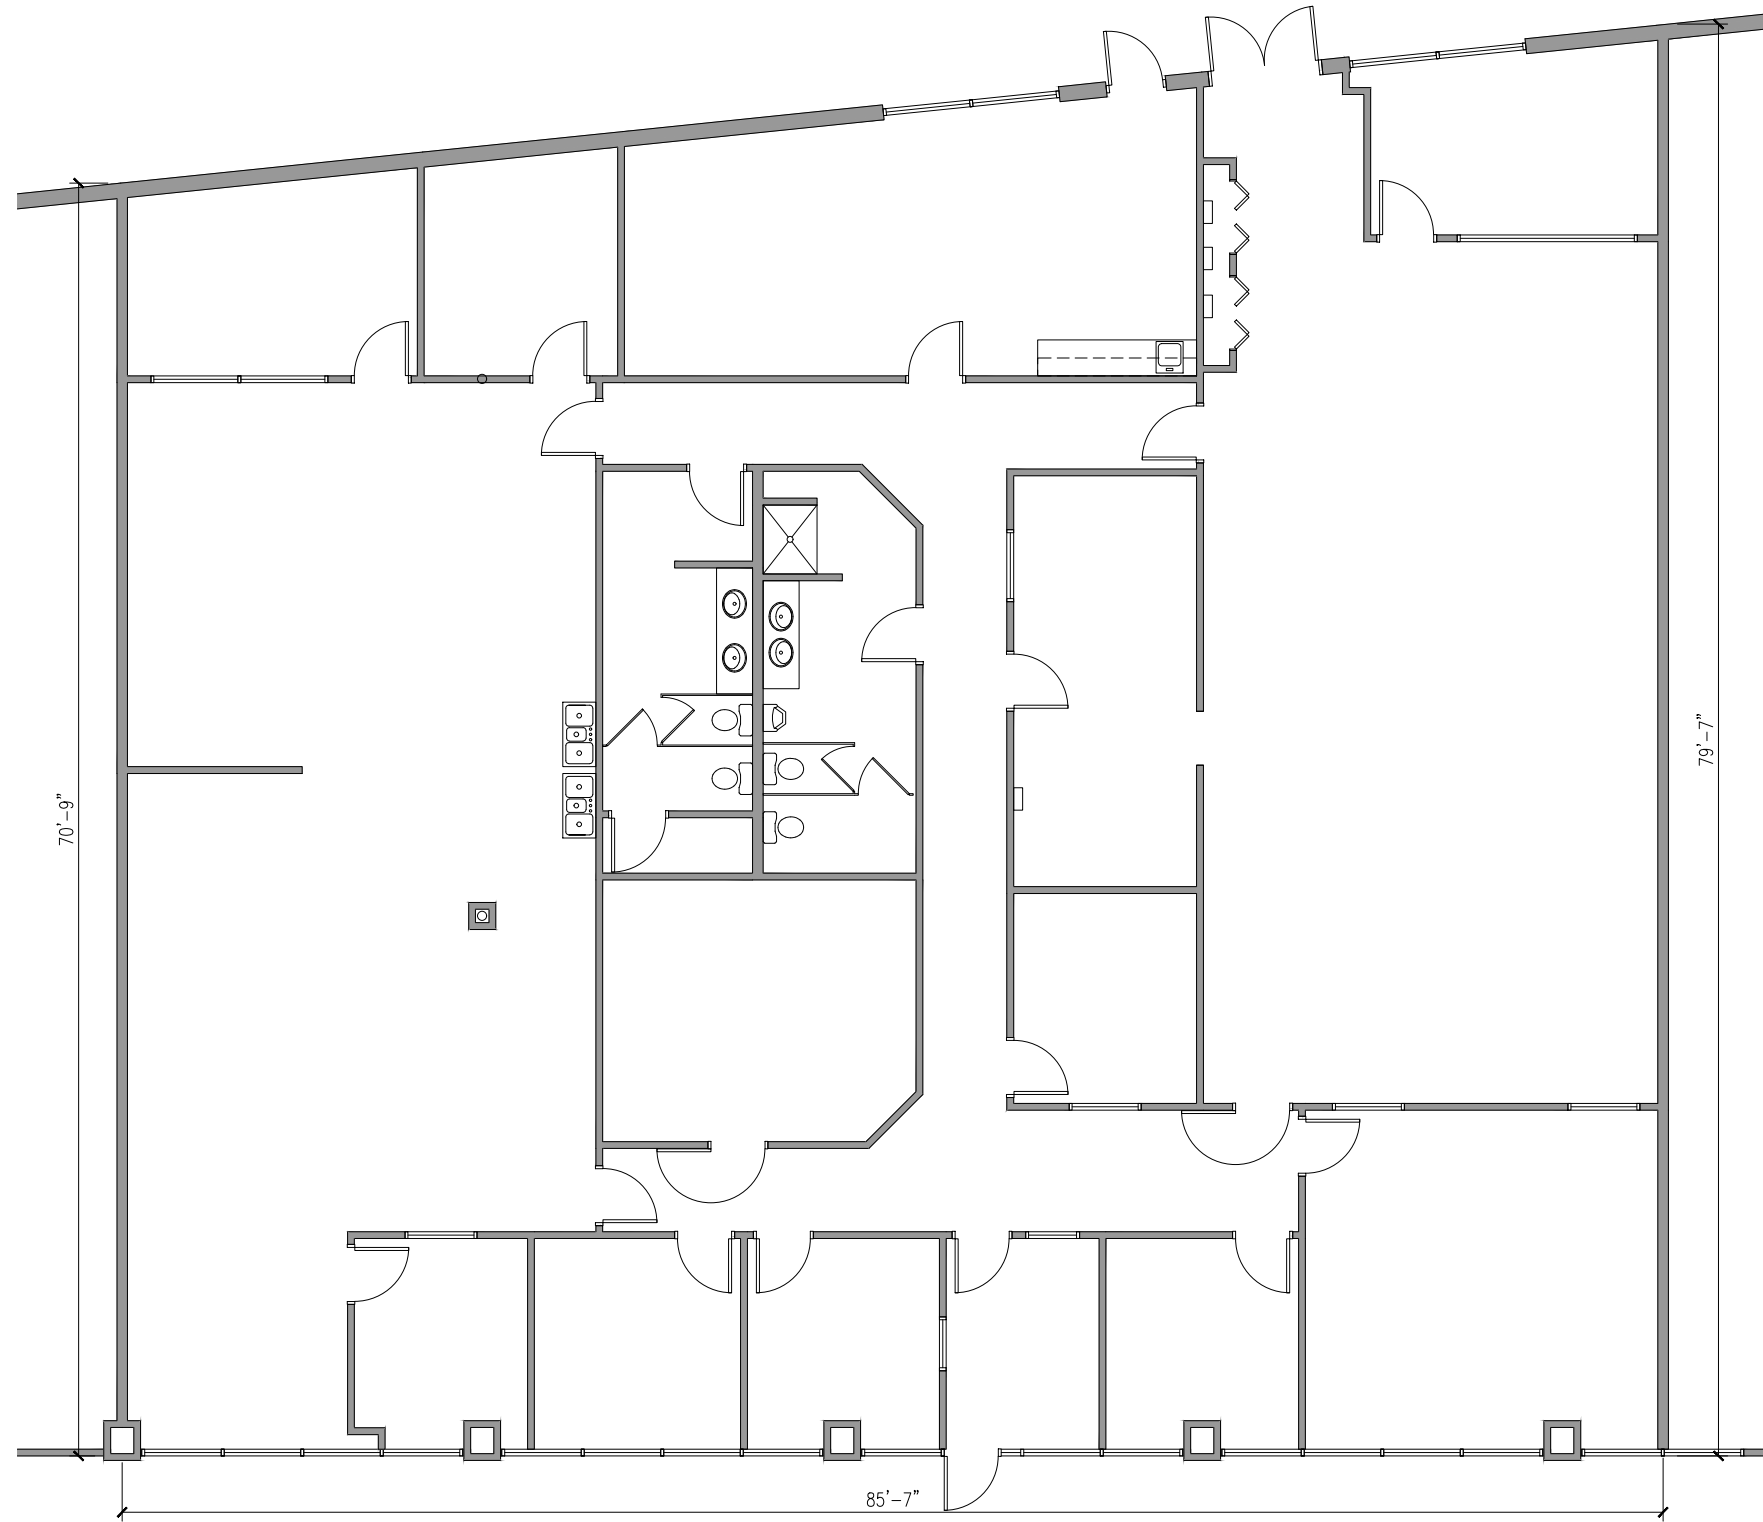

FLOOR PLAN - 6,422 SF
SCALE: 3/32" = 1'-0"