


TOTAL SF AVAILABLE - 2,712 RSF
OFFICE - 2,712 RSF

* INCLUDES % OF METER ROOM

[Click to access 3D model](#)

Key Plan

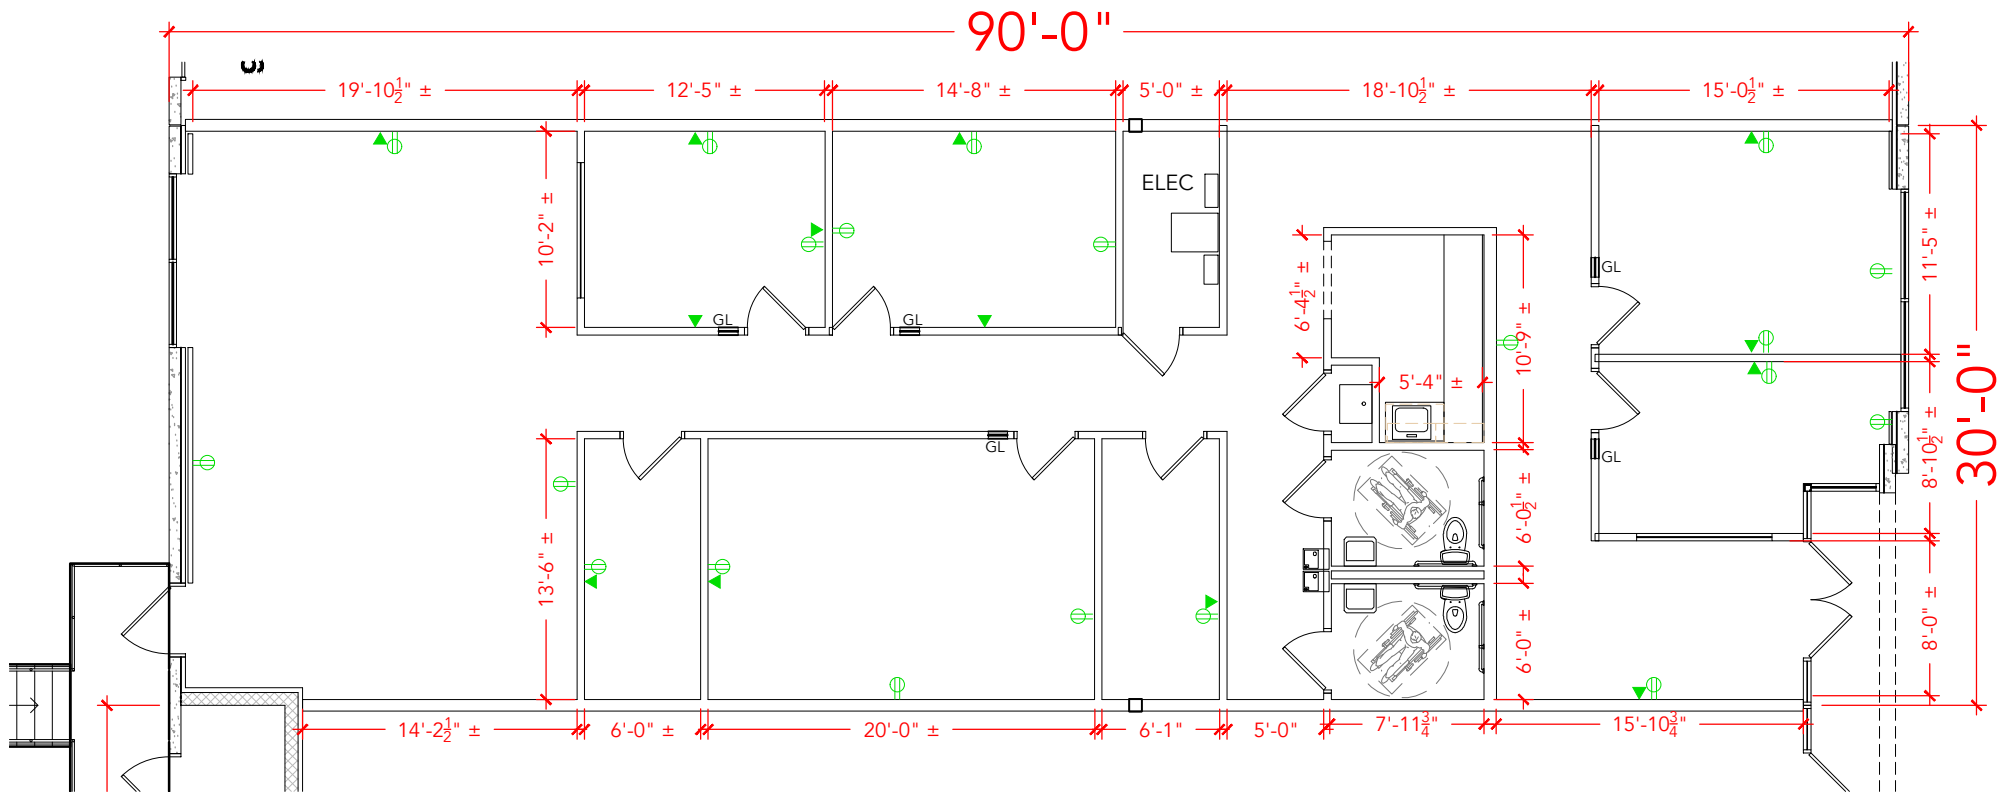

Floor Plan