


SPACE AVAILABLE

SUITE 500: 20,791 RSF

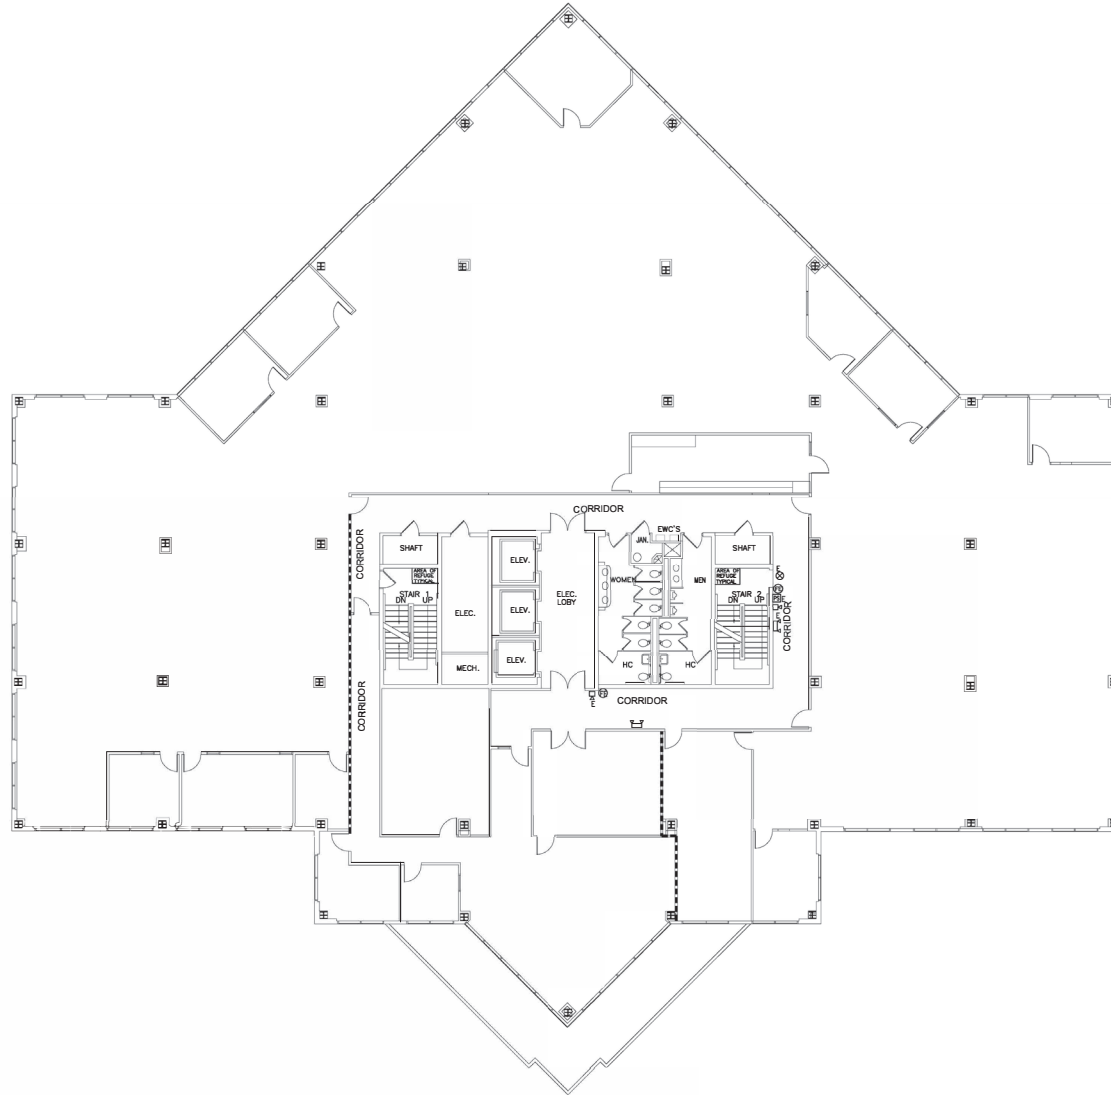

THE POINTE AT 1901
1901 Ulmerton Road
St. Petersburg, FL

No warranty or representation, expressed or implied, is made to the accuracy of information contained herein, and same is submitted subject to errors, change of price, rental or other conditions, withdrawal without notice, and to any special listing conditions imposed by our principals. PLANS NOT TO SCALE

NICK POLO
813.682.6194
Nick.Polo@FranklinSt.com

CHAD RUPP
813.345.5891
Chad.Rupp@FranklinSt.com

 **FranklinStreet**
Licensed Real Estate Broker | FranklinSt.com