



Parking Lot

Cliff Street

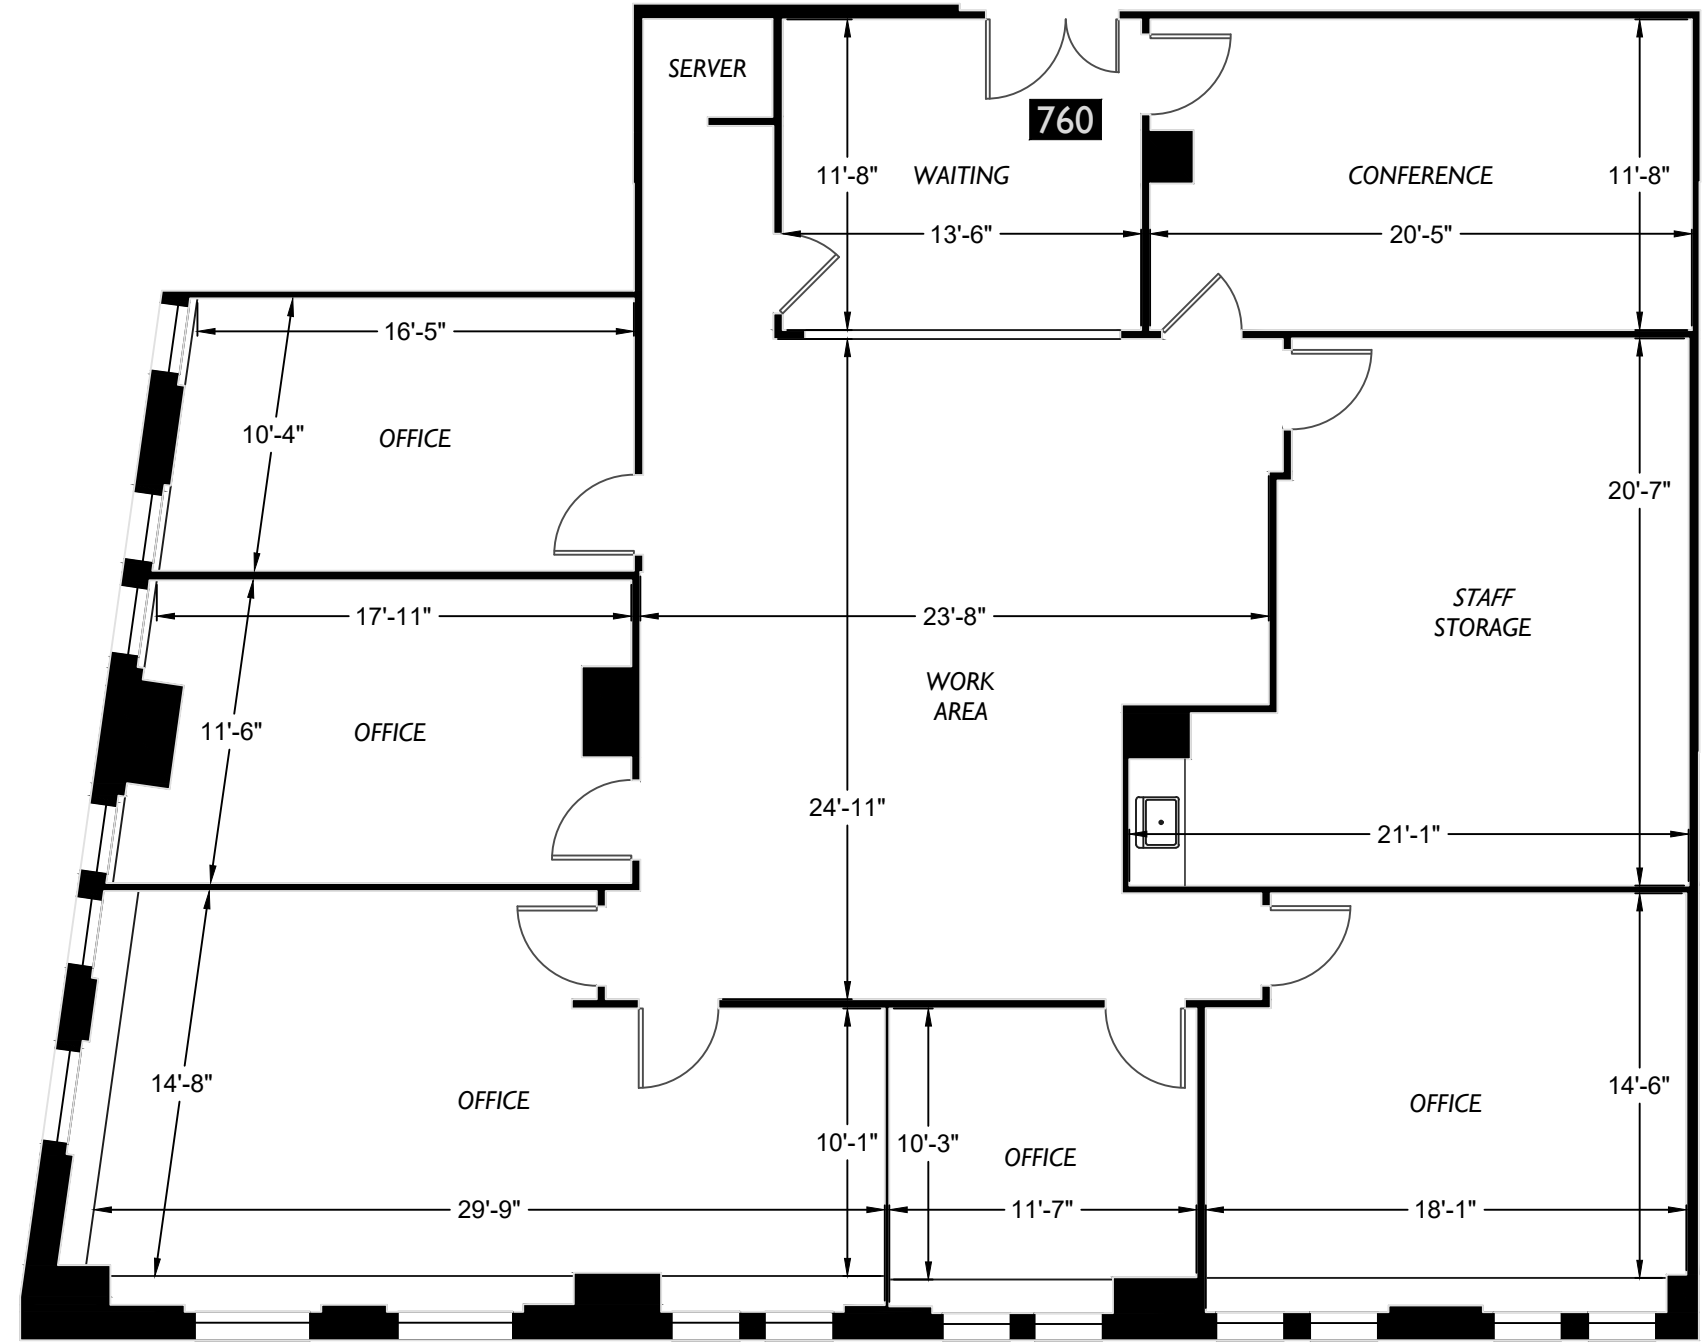

Pearl Street

John Street

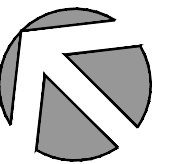


2DFLOORPLANS.COM
206-328-7410

2-D
AS-BUILT
FLOOR PLANS

600 NW Gilman Blvd. Suite E
Issaquah, WA 98027

Measured: September 2017 | Project: C22-1048

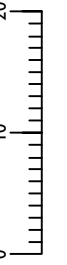

Scale

Floor Plan

SUITE 760

Office Building
111 John Street
New York, NY 10038

Subject

Braun Management, Inc.
160 Broadway, First Floor
New York, NY 10038

Client