


THIS DRAWING IS THE PROPERTY OF BELL & ASSOCIATES ARCHITECTS


9/20/2023 3:48:38 PM

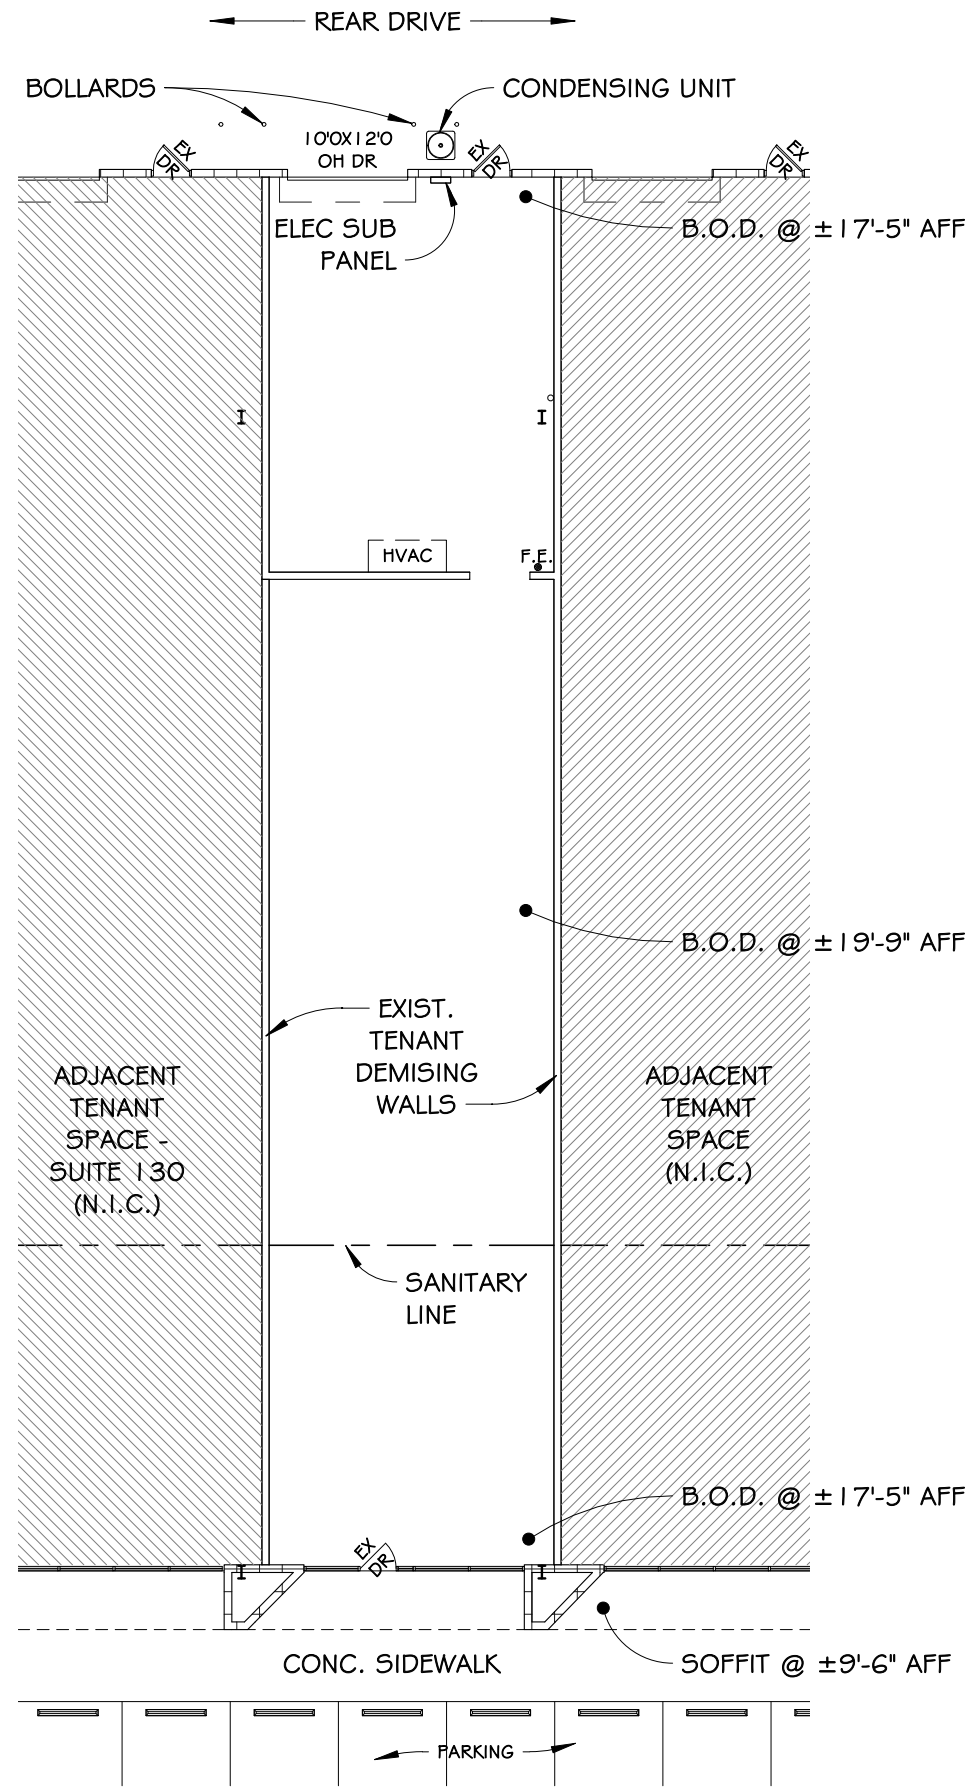

1 | AS-BUILT FLOOR PLAN - SUITE 130  
 AB-1 | 1/16" = 1'-0"

# NORTHLAKE BUSINESS PARK - SUITE 130

ARCHITECT

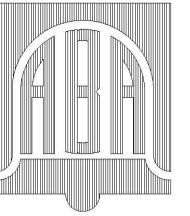

BELL & ASSOCIATES ARCHITECTS, INC.  
 128 LOVVORN ROAD  
 CARROLLTON, GA 30118  
 P) 770.830.8856

CLIENT

AMERICAN CAPITAL PROPERTIES

PROJECT

NORTHLAKE BUSINESS PARK - LEASE SPACE

1901 MONTREAL RD, SUITE 130  
 TUCKER, GA 30084

PROJECT NO. 2335-001

ISSUANCE:

|    |          |
|----|----------|
| 1  | 08/28/23 |
| 2  | 09/20/23 |
| 3  |          |
| 4  |          |
| 5  |          |
| 6  |          |
| 7  |          |
| 8  |          |
| 9  |          |
| 10 |          |

SHEET NO.

AB-1