
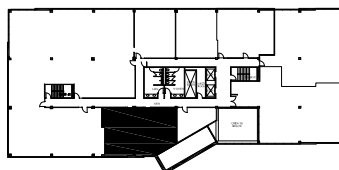


GRAYMARK OFFICE BUILDING

16801 Addison Road, Addison, Texas

SUITE 210
1,542 RSF

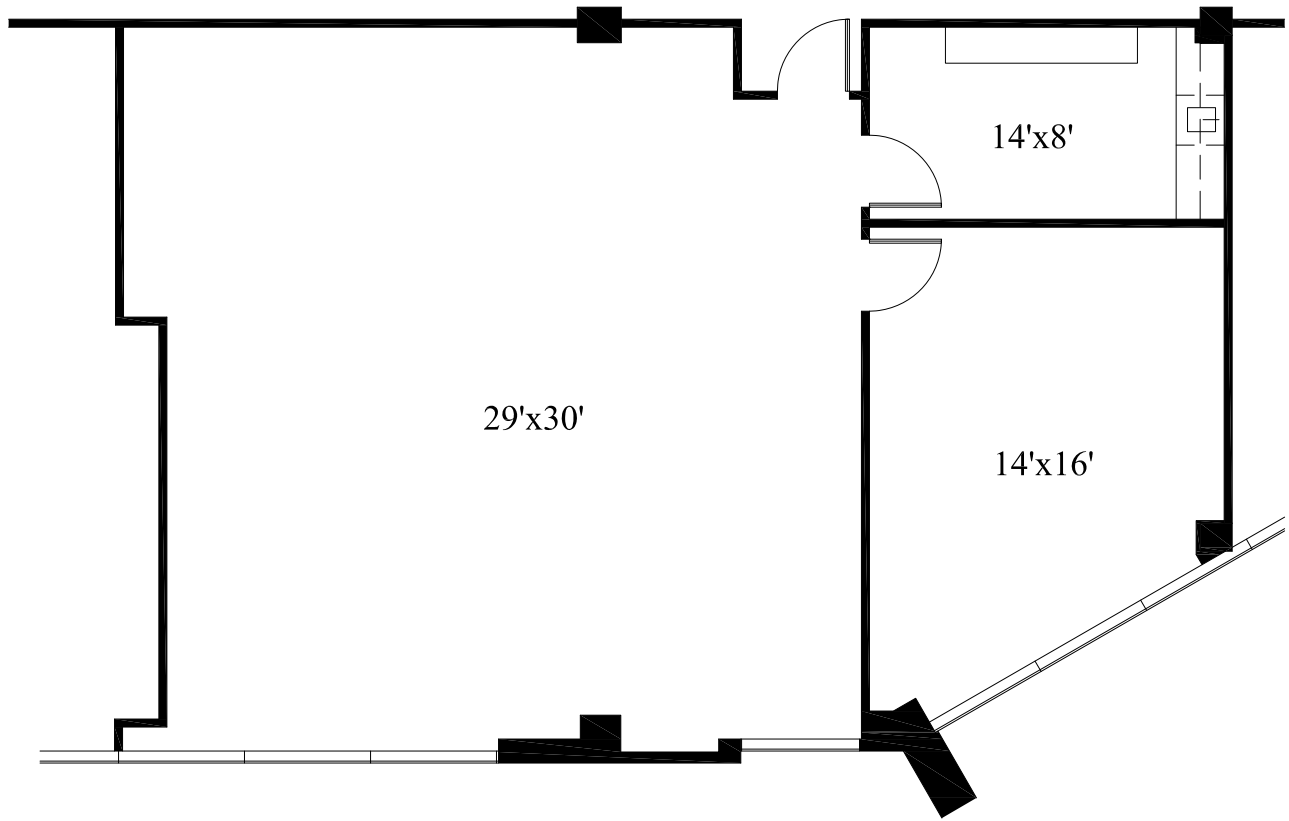

2ND FLOOR

Scale: 1/8"=1'-0"

All dimensions and square footages are approximate.

April 16, 2021

