

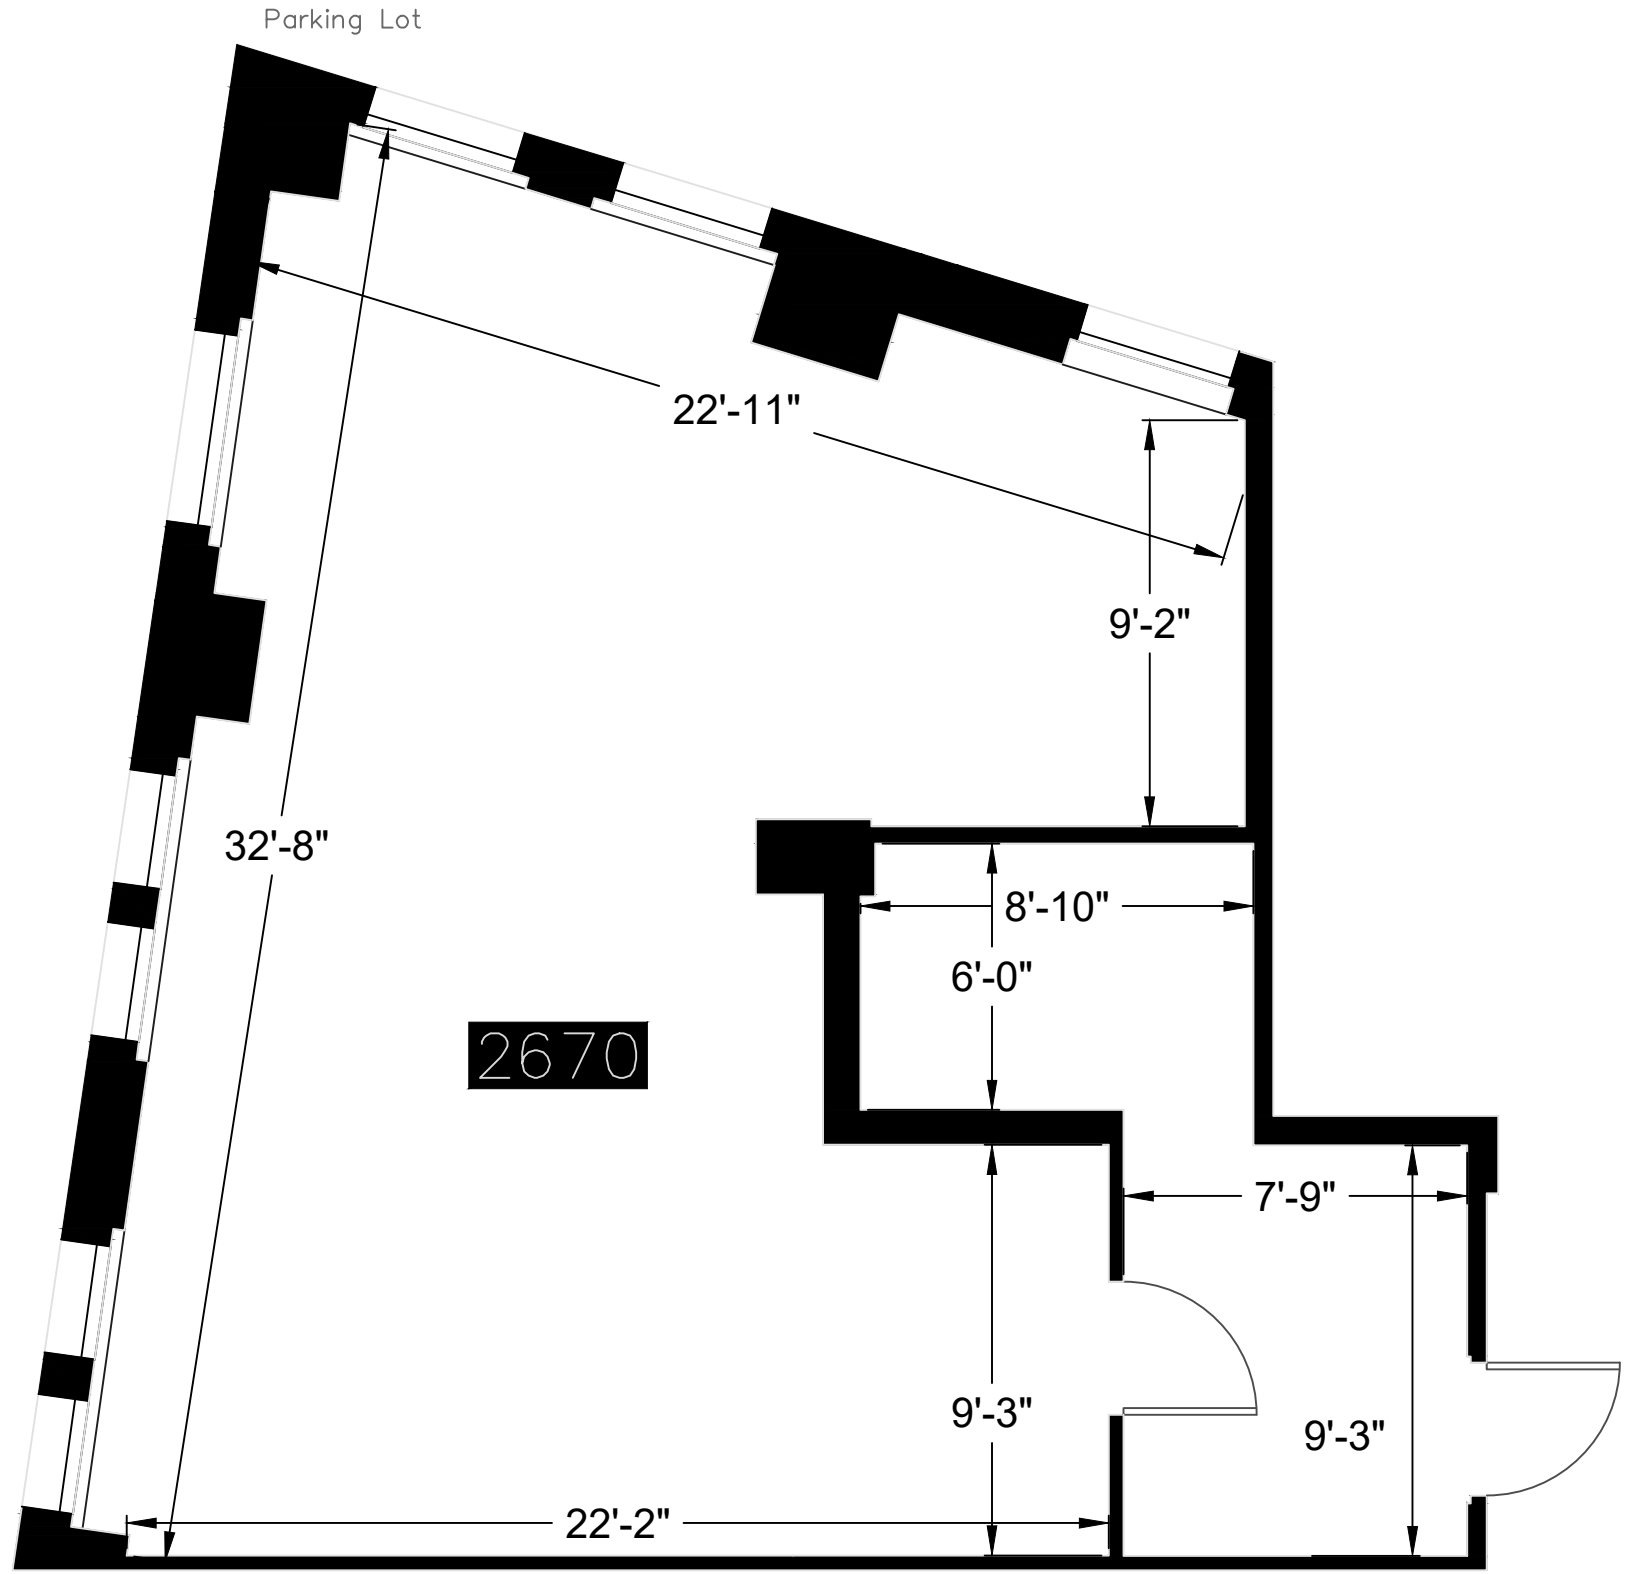


Cliff Street

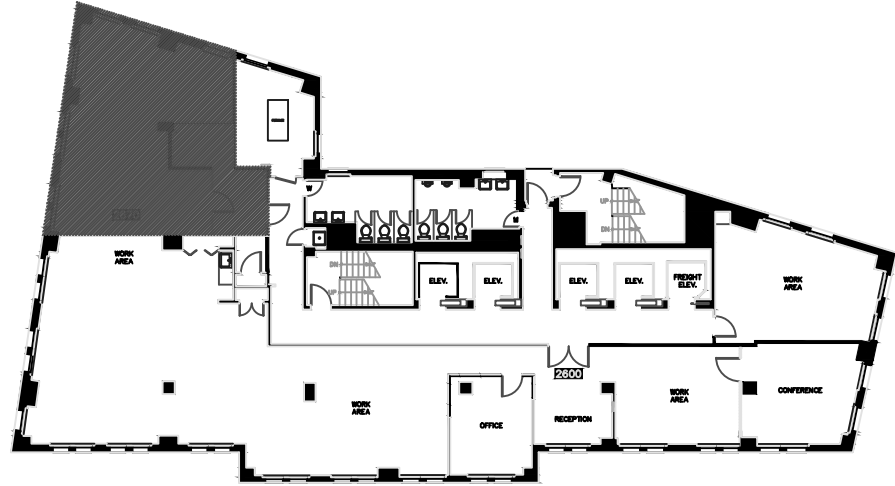

John Street


Pearl Street

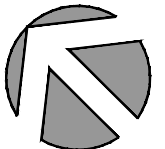

Client
 Braun Management, Inc.
 160 Broadway, First Floor
 New York, NY 10038

Subject
 Office Building
 111 John Street
 New York, NY 10038

Floor Plan
 SUITE 2670

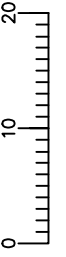

2-D
 AS-BUILT
 FLOOR PLANS
 2DFLOORPLANS.COM
 206-328-7410
 600 NW Gilman Blvd. Suite E
 Issaquah, WA 98027
 Measured: September 21, 2011
 Project: C24-454