


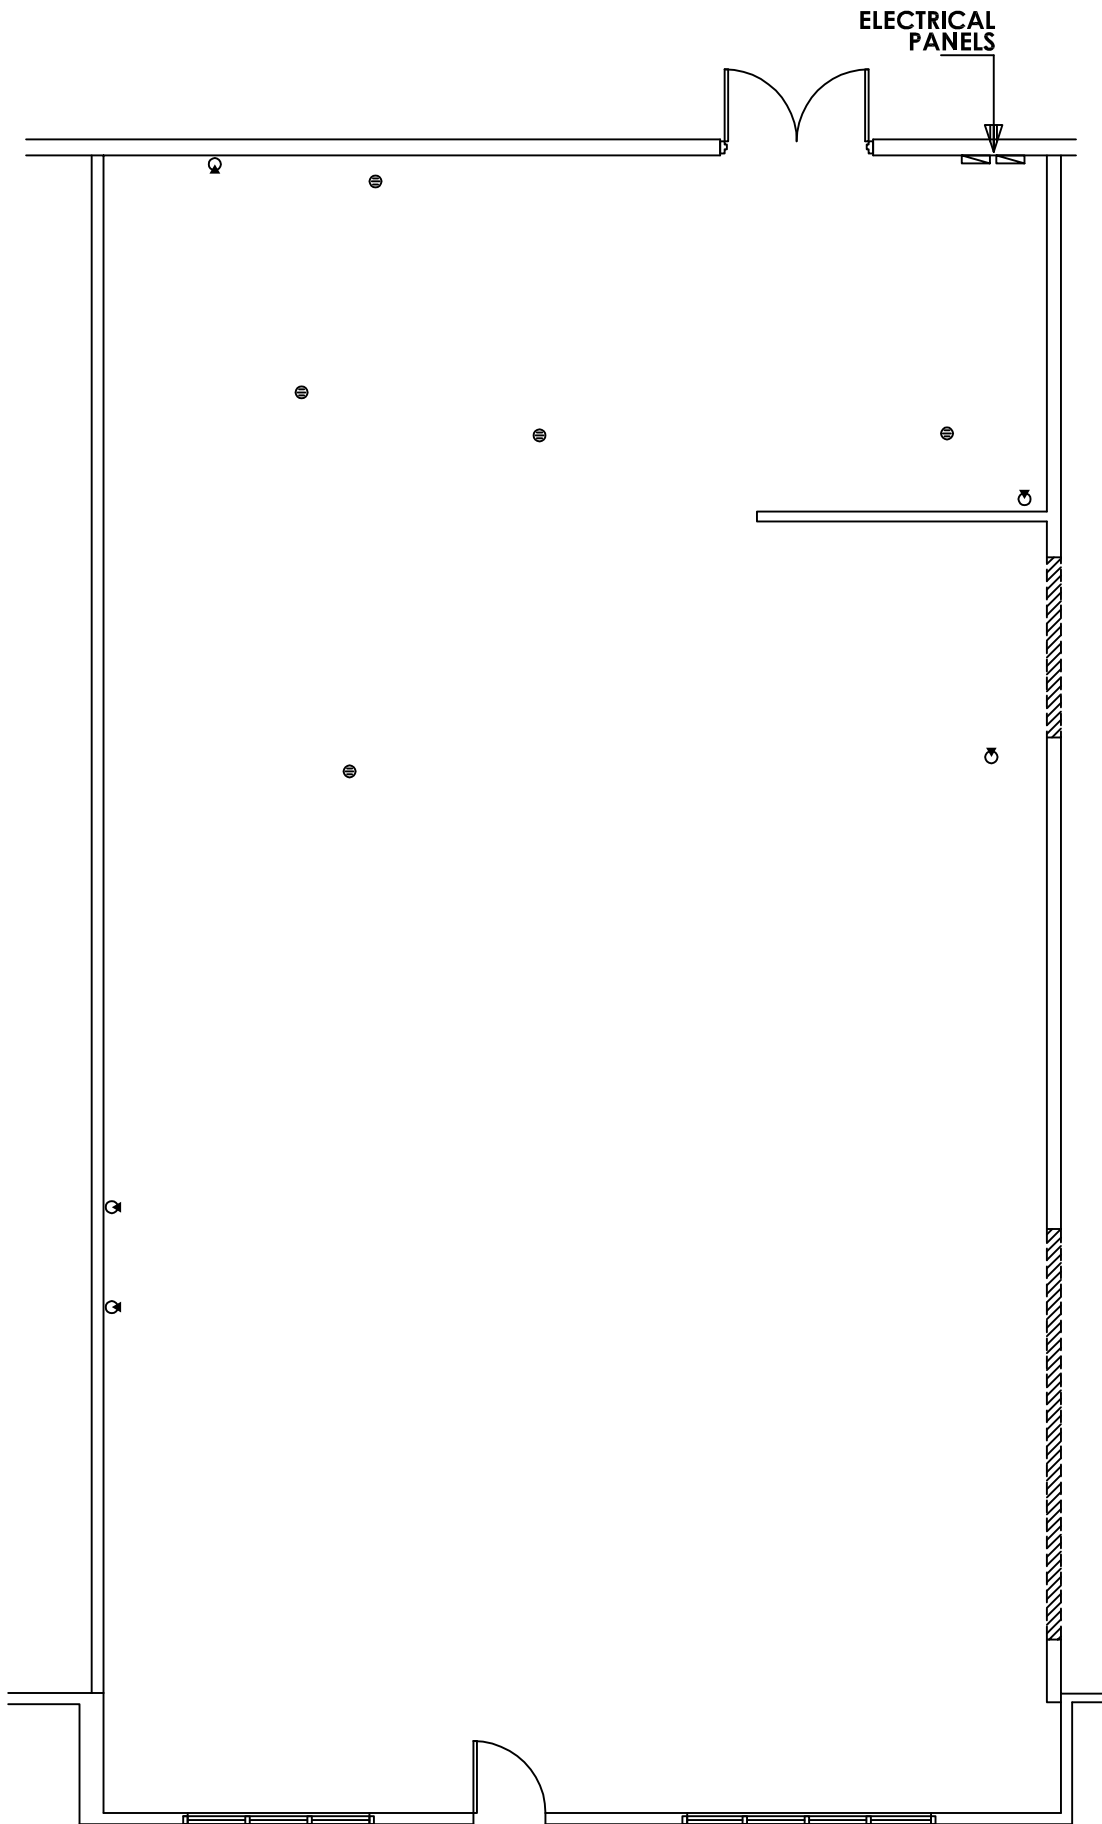

AS-BUILT FLOOR PLAN
1/8"=1'-0"



NORTH

MARCH 3, 2011
CHIMNEY POINT
8988 S. SHERIDAN
TULSA, OKLAHOMA 74137
THE SANDITEN COMPANIES
3314 EAST 51ST STREET
SUITE 200A
TULSA, OKLAHOMA 74135
(918)742-3315