


1 **Reduced As-built**  
Suite 704

Scale: 1/8" = 1'-0"

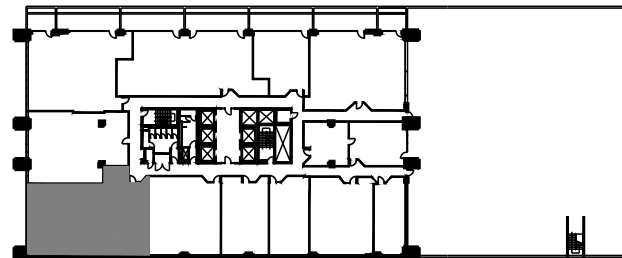

Proximity Plan

Suite 704  
*The Chancery*  
2,942 RSF