


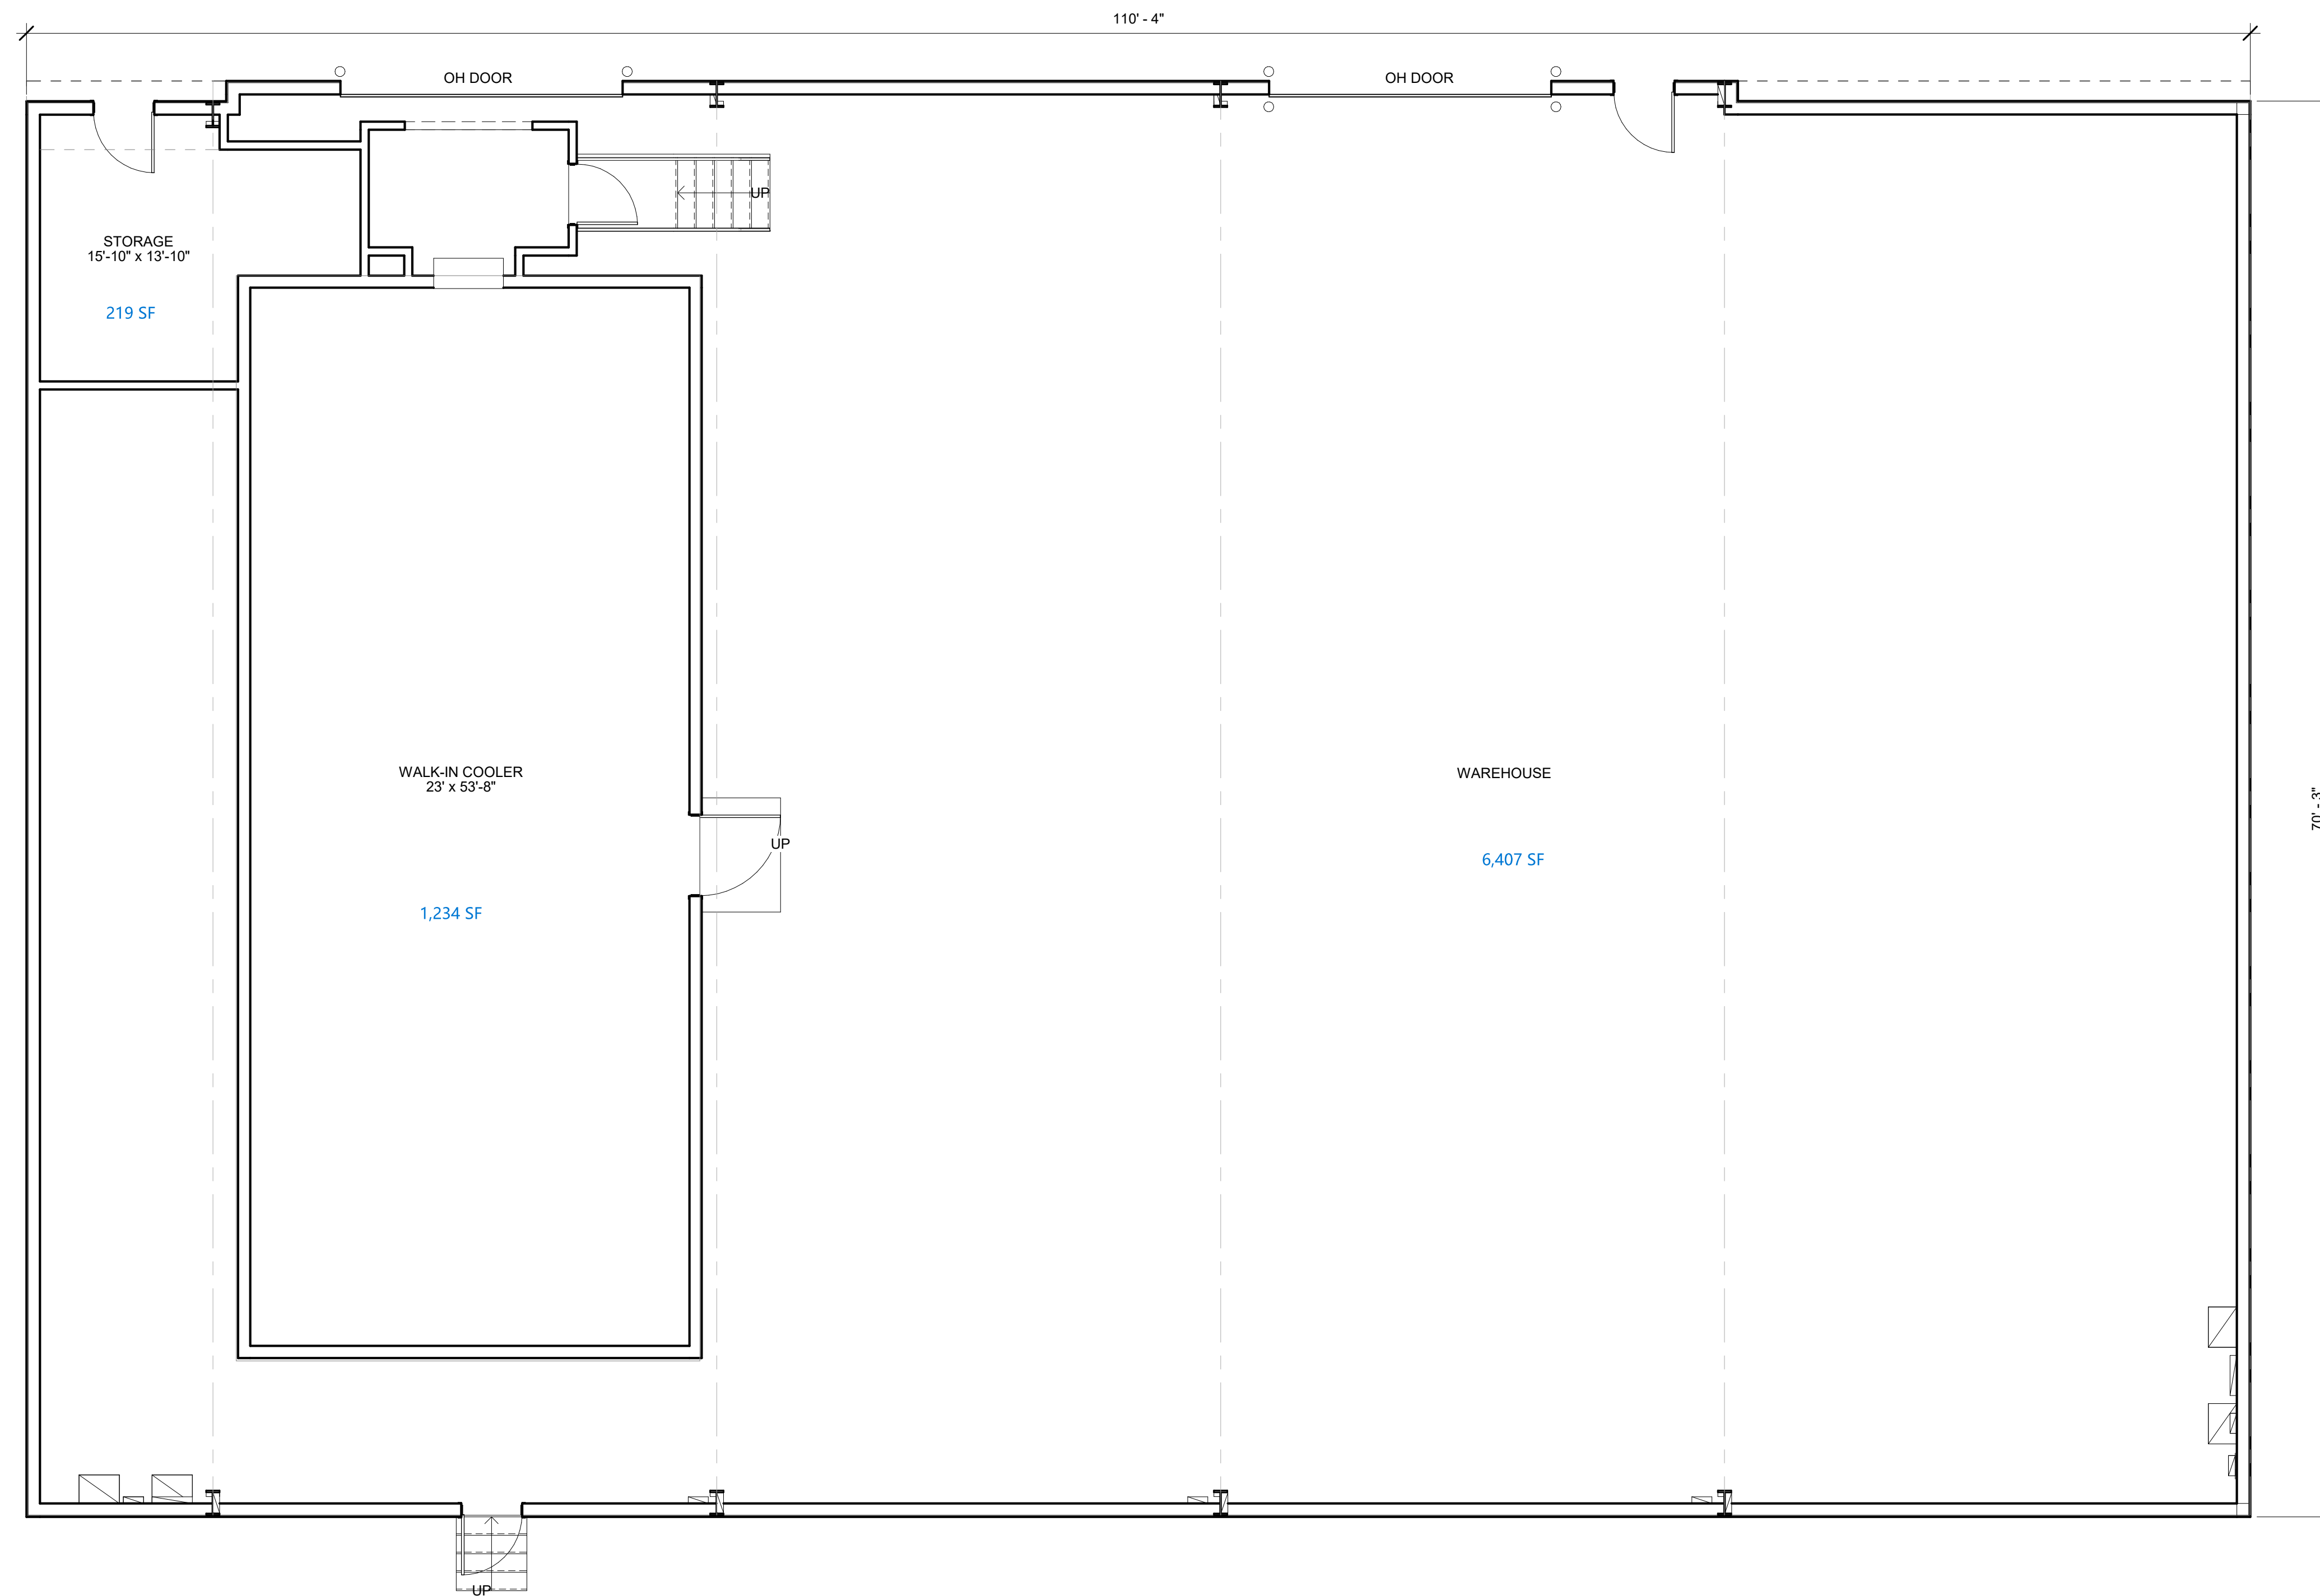

① Existing Bldg 1
3/16" = 1'-0"

15562 Capital Port - As-Built Floor Plan-Bldg. 1

15562 Capital Port Dr. San Antonio, TX 78249

Area: 7,860 SF

02/11/25

Scale: 3/16" = 1'-0"

LKDG Prj. No: 25014