


LAKE SHORE

18111 VON KARMAN AVENUE

7th floor

AIRPORT

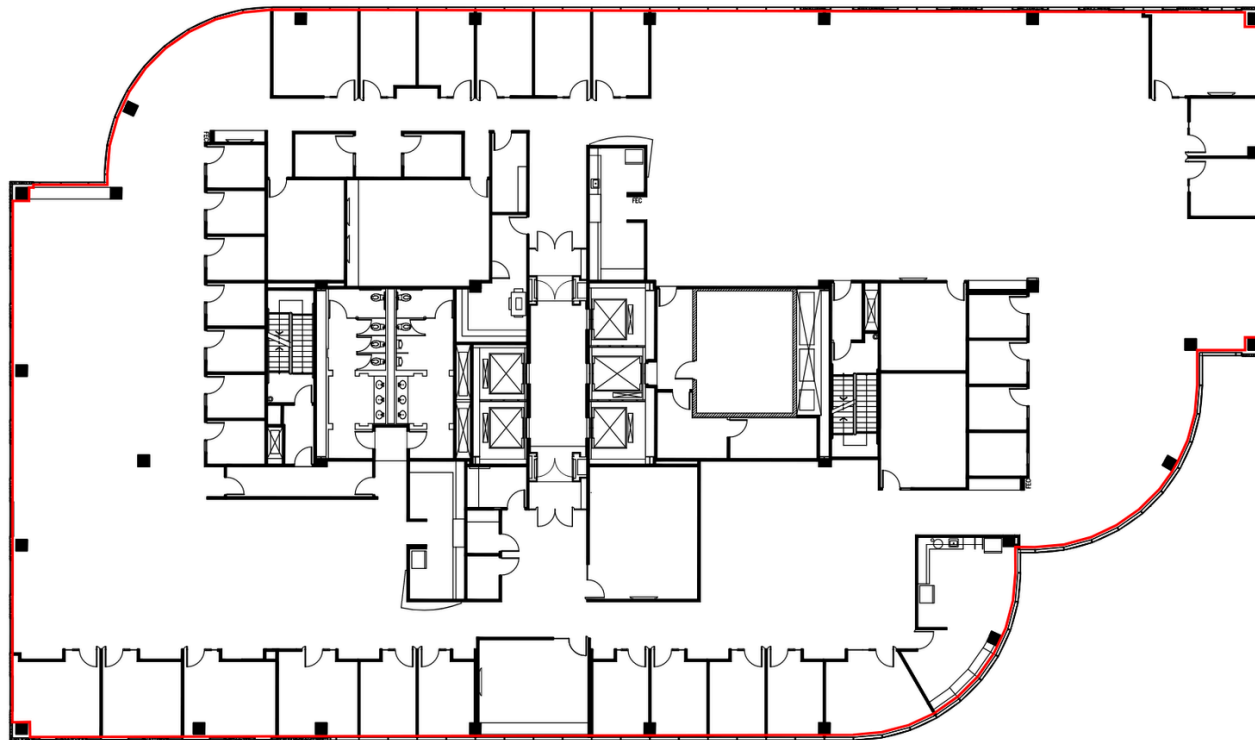

405 FREEWAY



"AVAILABLE"
SUITE 700 | 24,649 RSF

SCALE: N.T.S.



SENTRE

REVISED: 1/17/26