

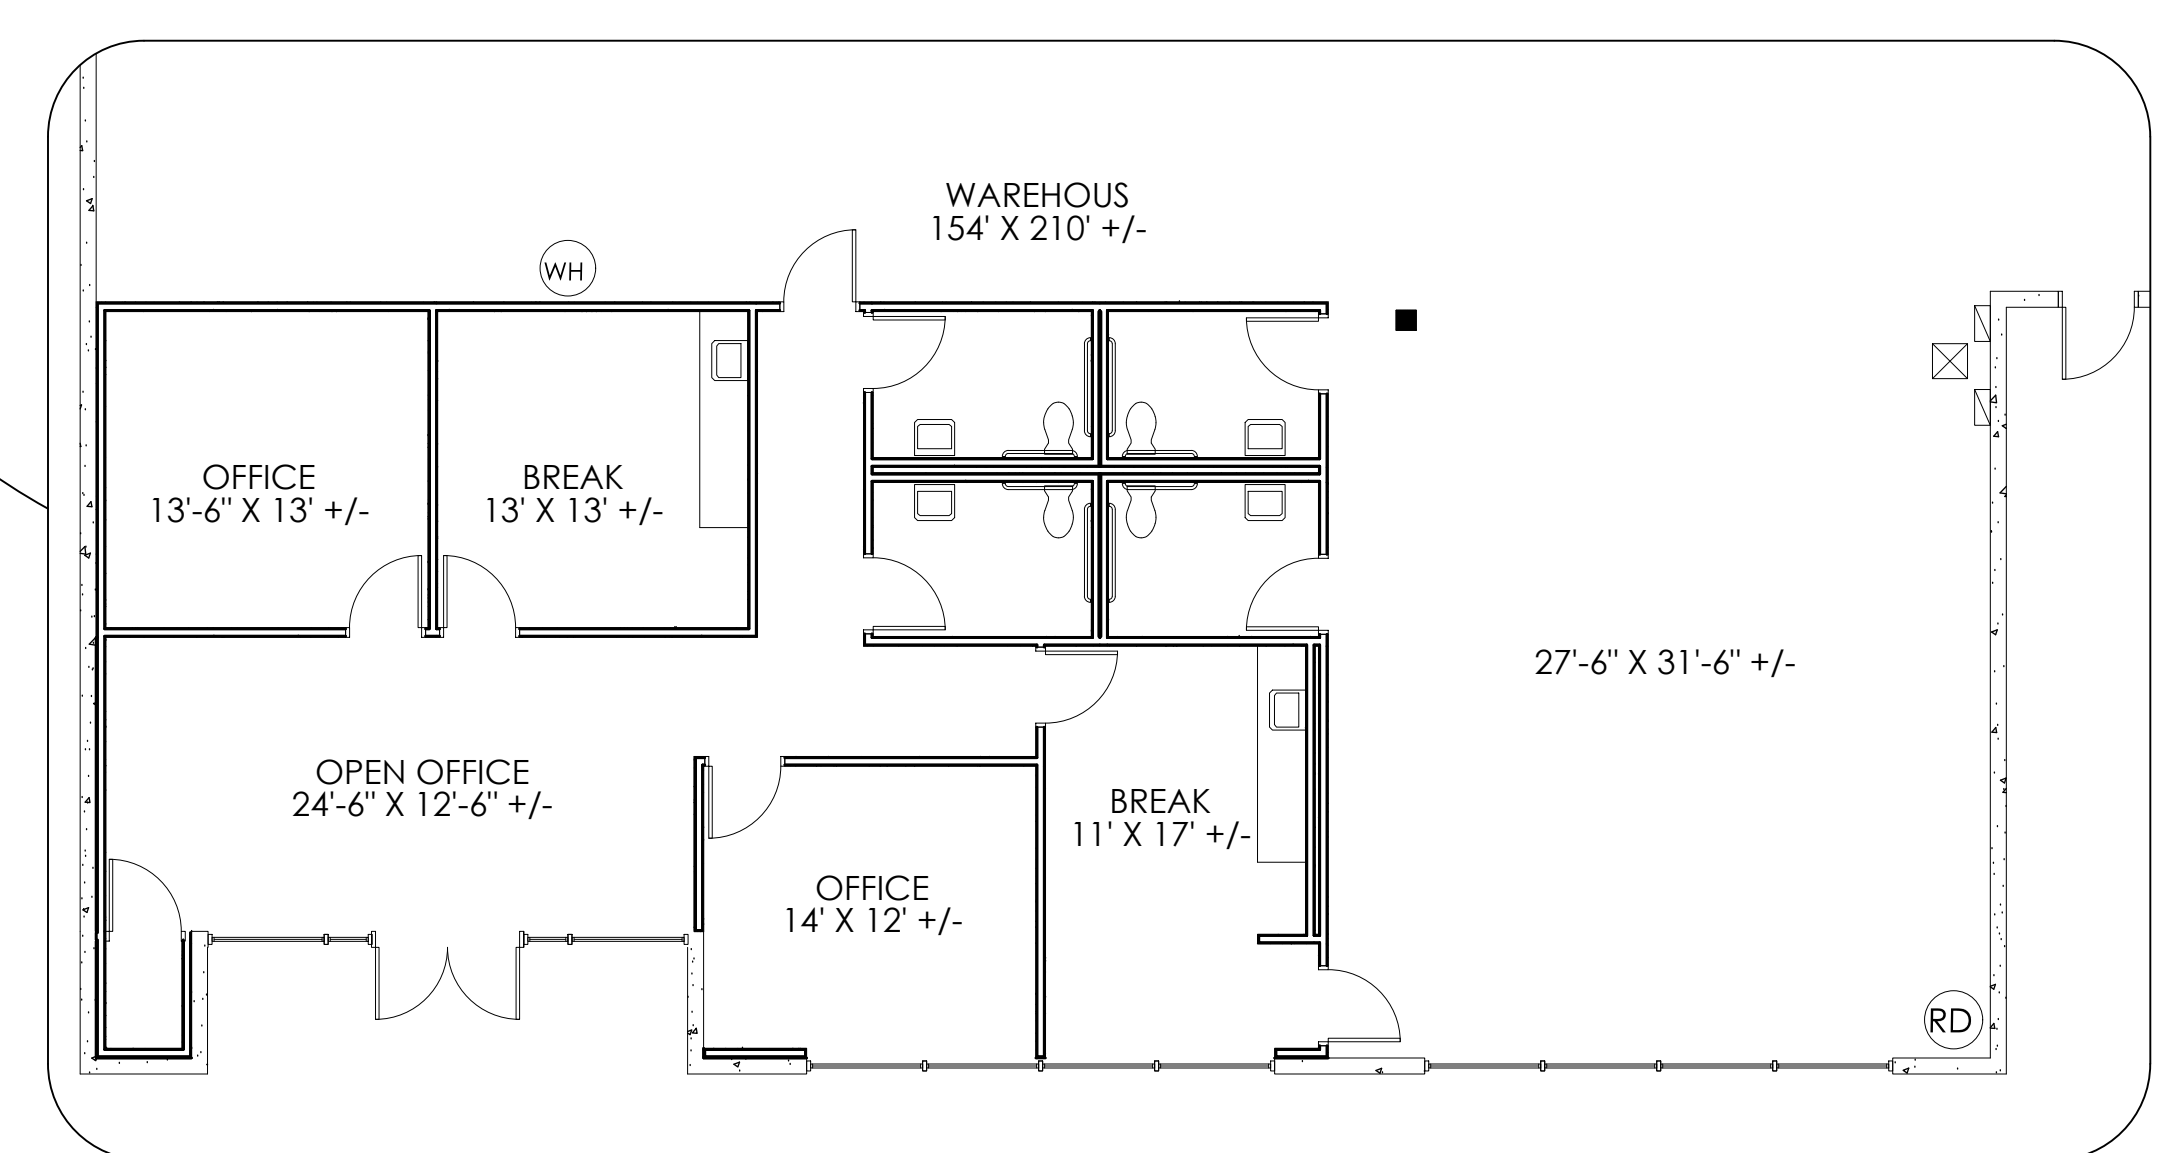


EXISTING AS-BUILT FLOOR PLAN

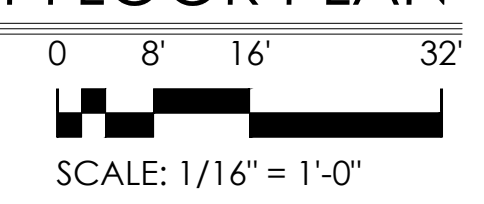


OFFICE 1 - ENLARGED AS BUILT FLOOR PLAN

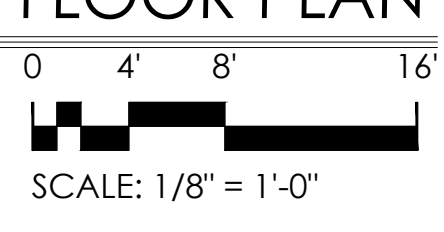


BUILDING INFORMATION

	SQFT	BUILDING PERCENTAGE
OFFICE 1	1,555	1%
OFFICE 2	1,160	1%
WAREHOUSE:	100,292	98%
TOTAL AREA:	103,007	
Deck Height:		33'-6"
Clear Height:		30'-0"
Ceiling Height:		N/A
Sprinklered:		ESFR
Mechanical Area:		FIRE PUMP

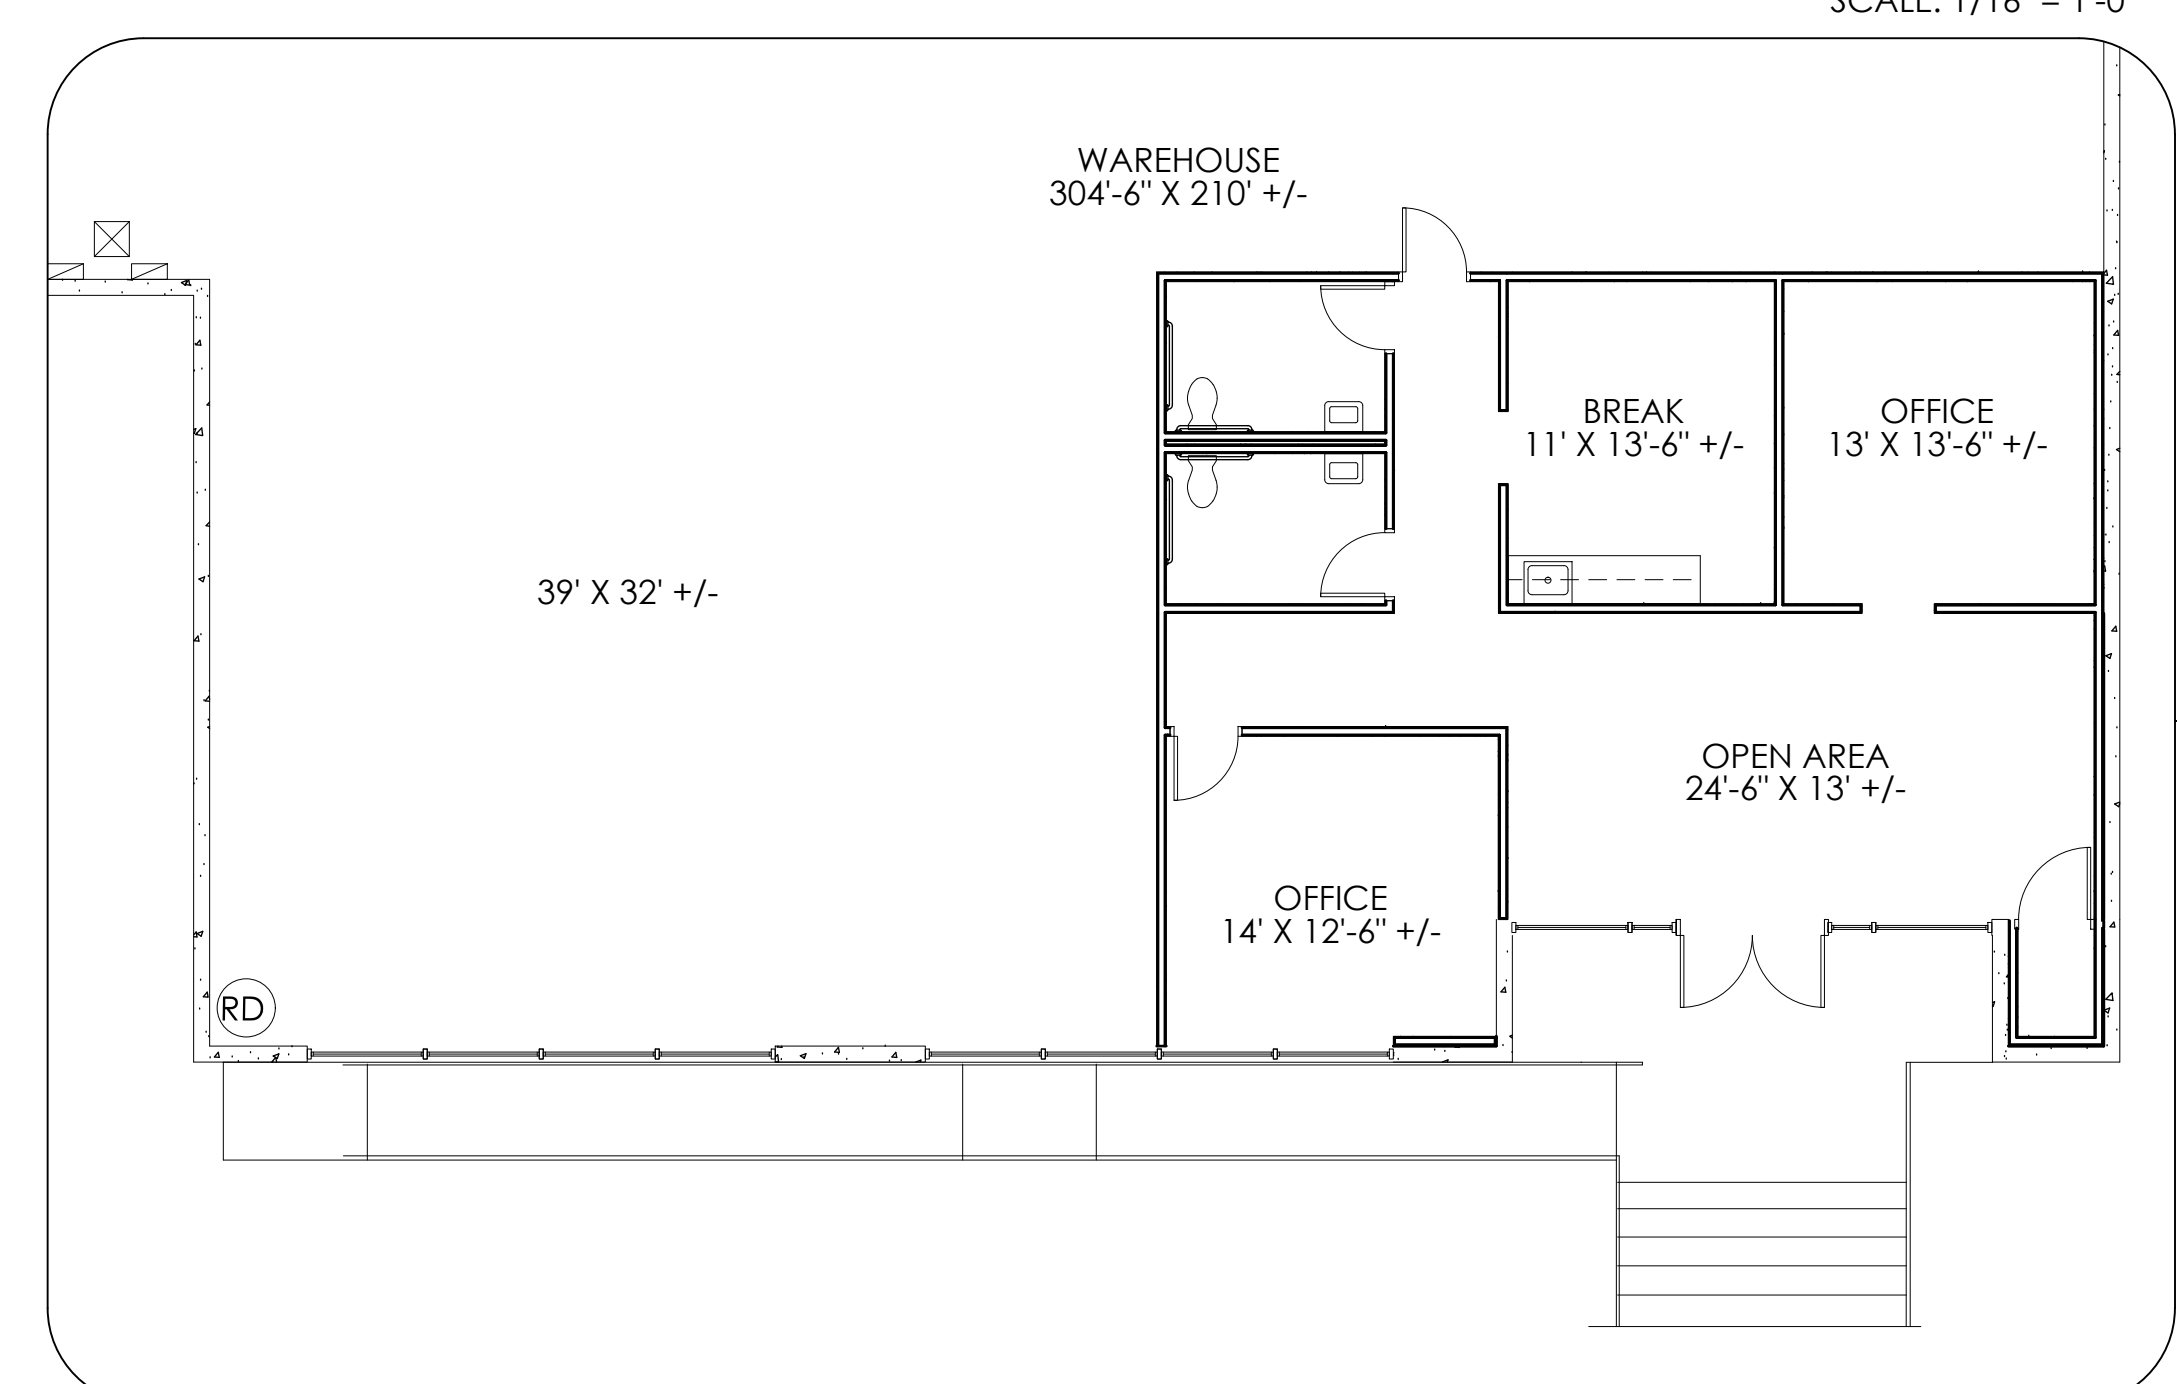

OFFICE 2 - ENLARGED AS BUILT FLOOR PLAN

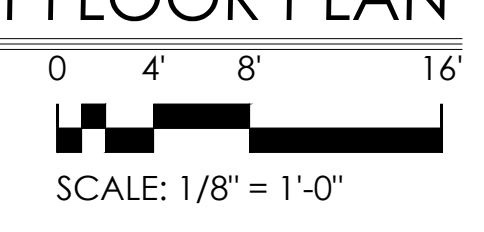

SCALE: VARIES
on 42'x30" plot
ISSUE DATES:
04/25/2025
AS BUILT | MARKETING
04/28/2025
REVISION