

GRANITE  
VALLEY  
MEDICAL  
OFFICE

14506 W GRANITE VALLEY DR | SUN CITY WEST, AZ 85375


## Floor 2

Suite 221

AS-BUILT

810 SF

AVAILABLE

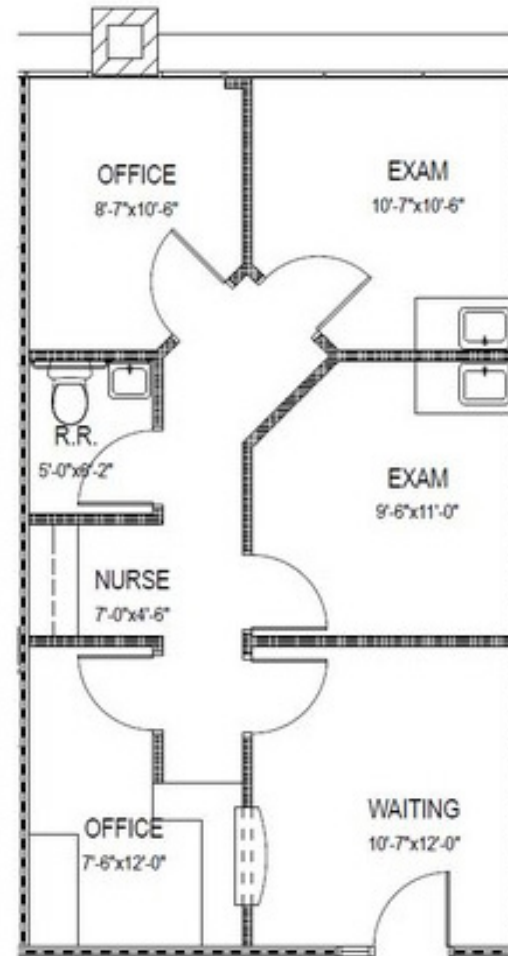

**RACHAEL THOMPSON**  
Senior Vice President  
602.513.5122  
rachael.thompson@kidder.com

**PERRY GABUZZI, CCIM**  
Senior Vice President  
602.513.5116  
perry.gabuzzi@kidder.com