



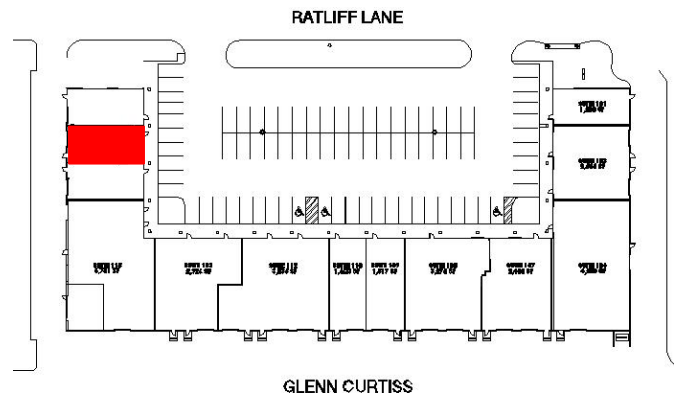

Z PROJECTS, LLC  
1418 JACKSON RD.  
KELLER, TX 75262  
817.873.1906  
www.linkedin.com/in/davezobrist

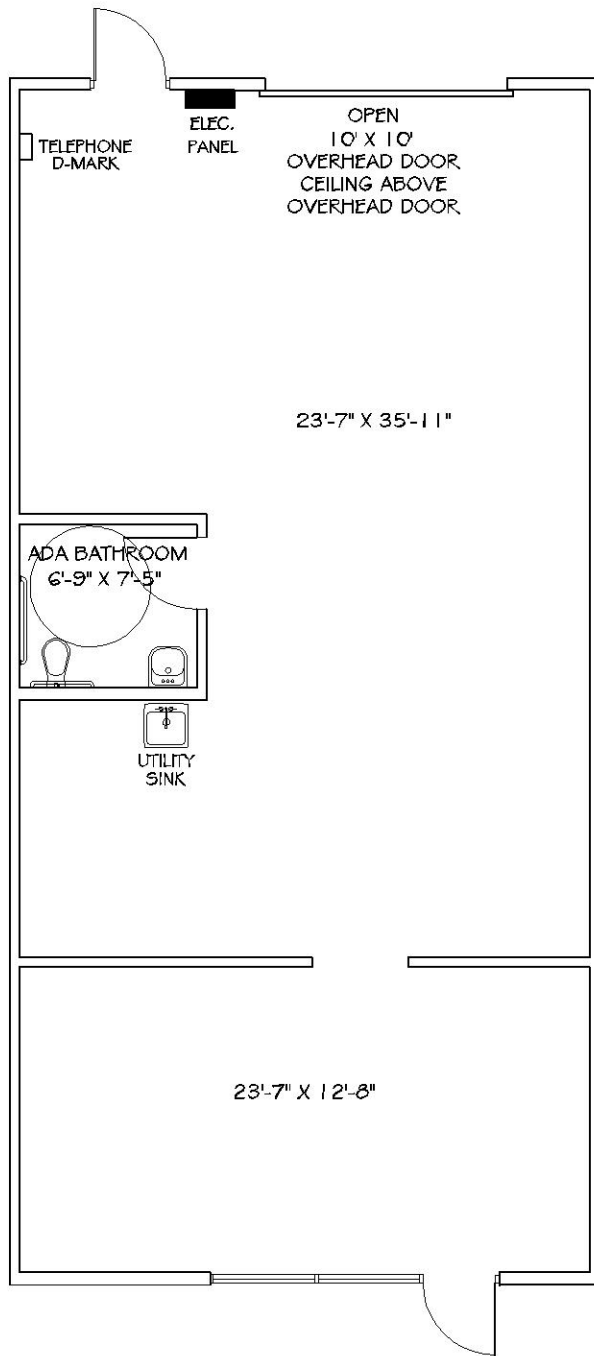

ROBERT B. POWELL, CCIM  
POWELL REALTY ADVISORS, LLC.  
214-908-3488  
Robert.Powell@PowellRealtyAdvisors.com

**AIRPORT PLAZA**  
SUITE 118 | 2,000 SF  
4500 RATLIFF | ADDISON, TX 75001

**AS BUILT**

11.05.2025