



Suite 1475 - As built

4,211 RSF

- 7 enclosed rooms
- Large training room or team room
- Kitchen
- Bright corner suite with double door identity
- Available now

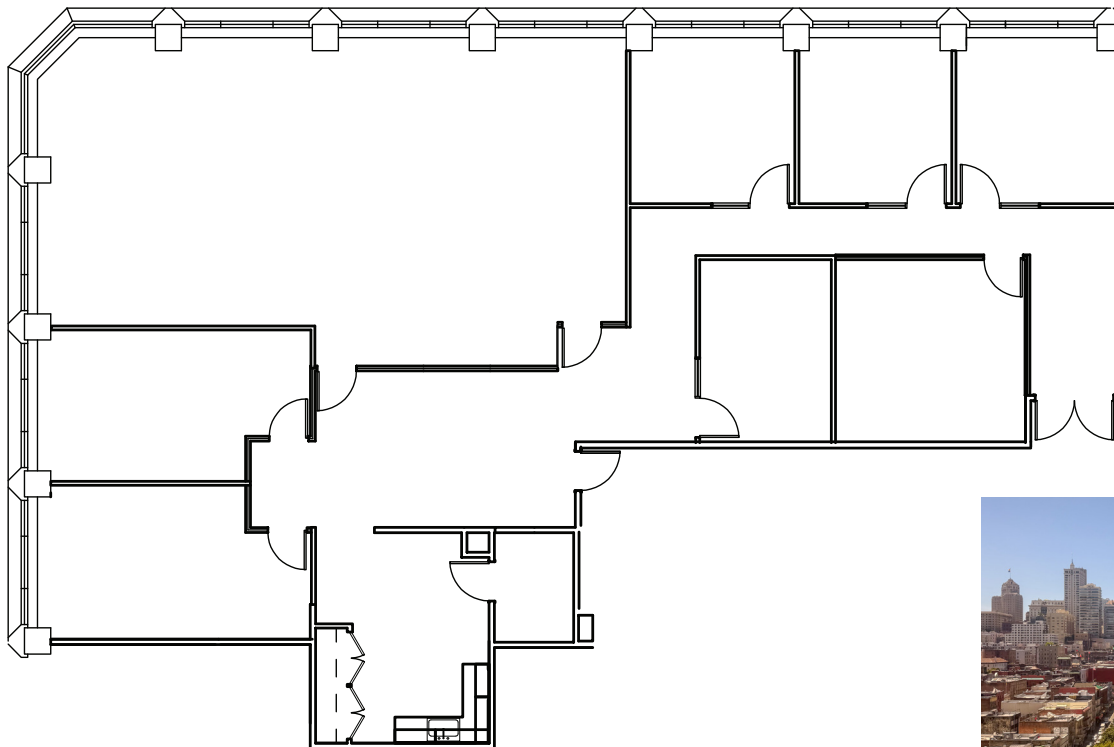

601

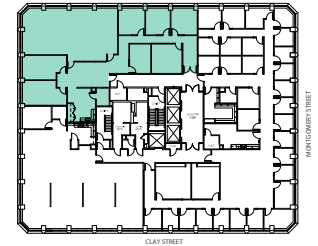

Kelly Glass
+1 415.322.5062
kelly.glass@avisonyoung.com
RE Lic #01335179

Shaw Blaisdell
+1 213.651.5137
shaw.blaisdell@avisonyoung.com
RE Lic #02352442

Melinda Ta
+1 415.301.3182
melinda.ta@avisonyoung.com
RE Lic #01937218

