

**CENTRAL  
PHYSICIANS  
PLAZA**


# Floor 03

## Suite 306

AS-BUILT

## 984 SF

AVAILABLE

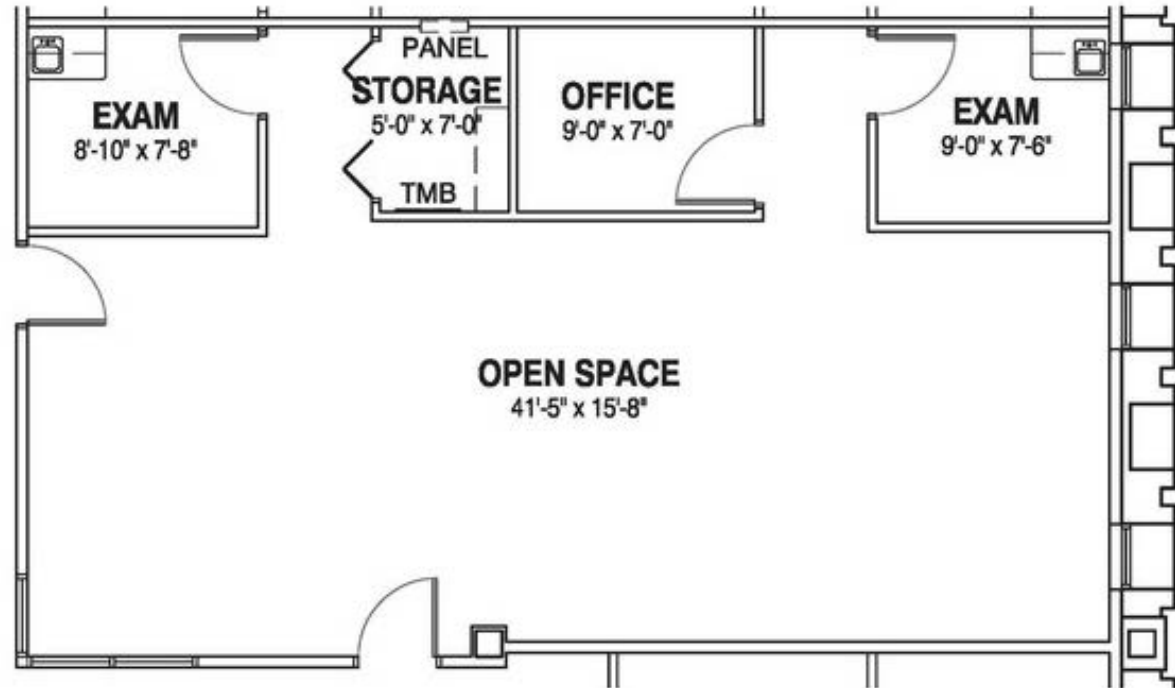

\*CONTIGUOUS TO SUITE 306A AND 312 FOR 8,156 SF

**RACHAEL THOMPSON**  
Senior Vice President  
602.513.5122  
rachael.thompson@kidder.com

**PERRY GABUZZI, CCIM**  
Senior Vice President  
602.513.5116  
perry.gabuzzi@kidder.com