
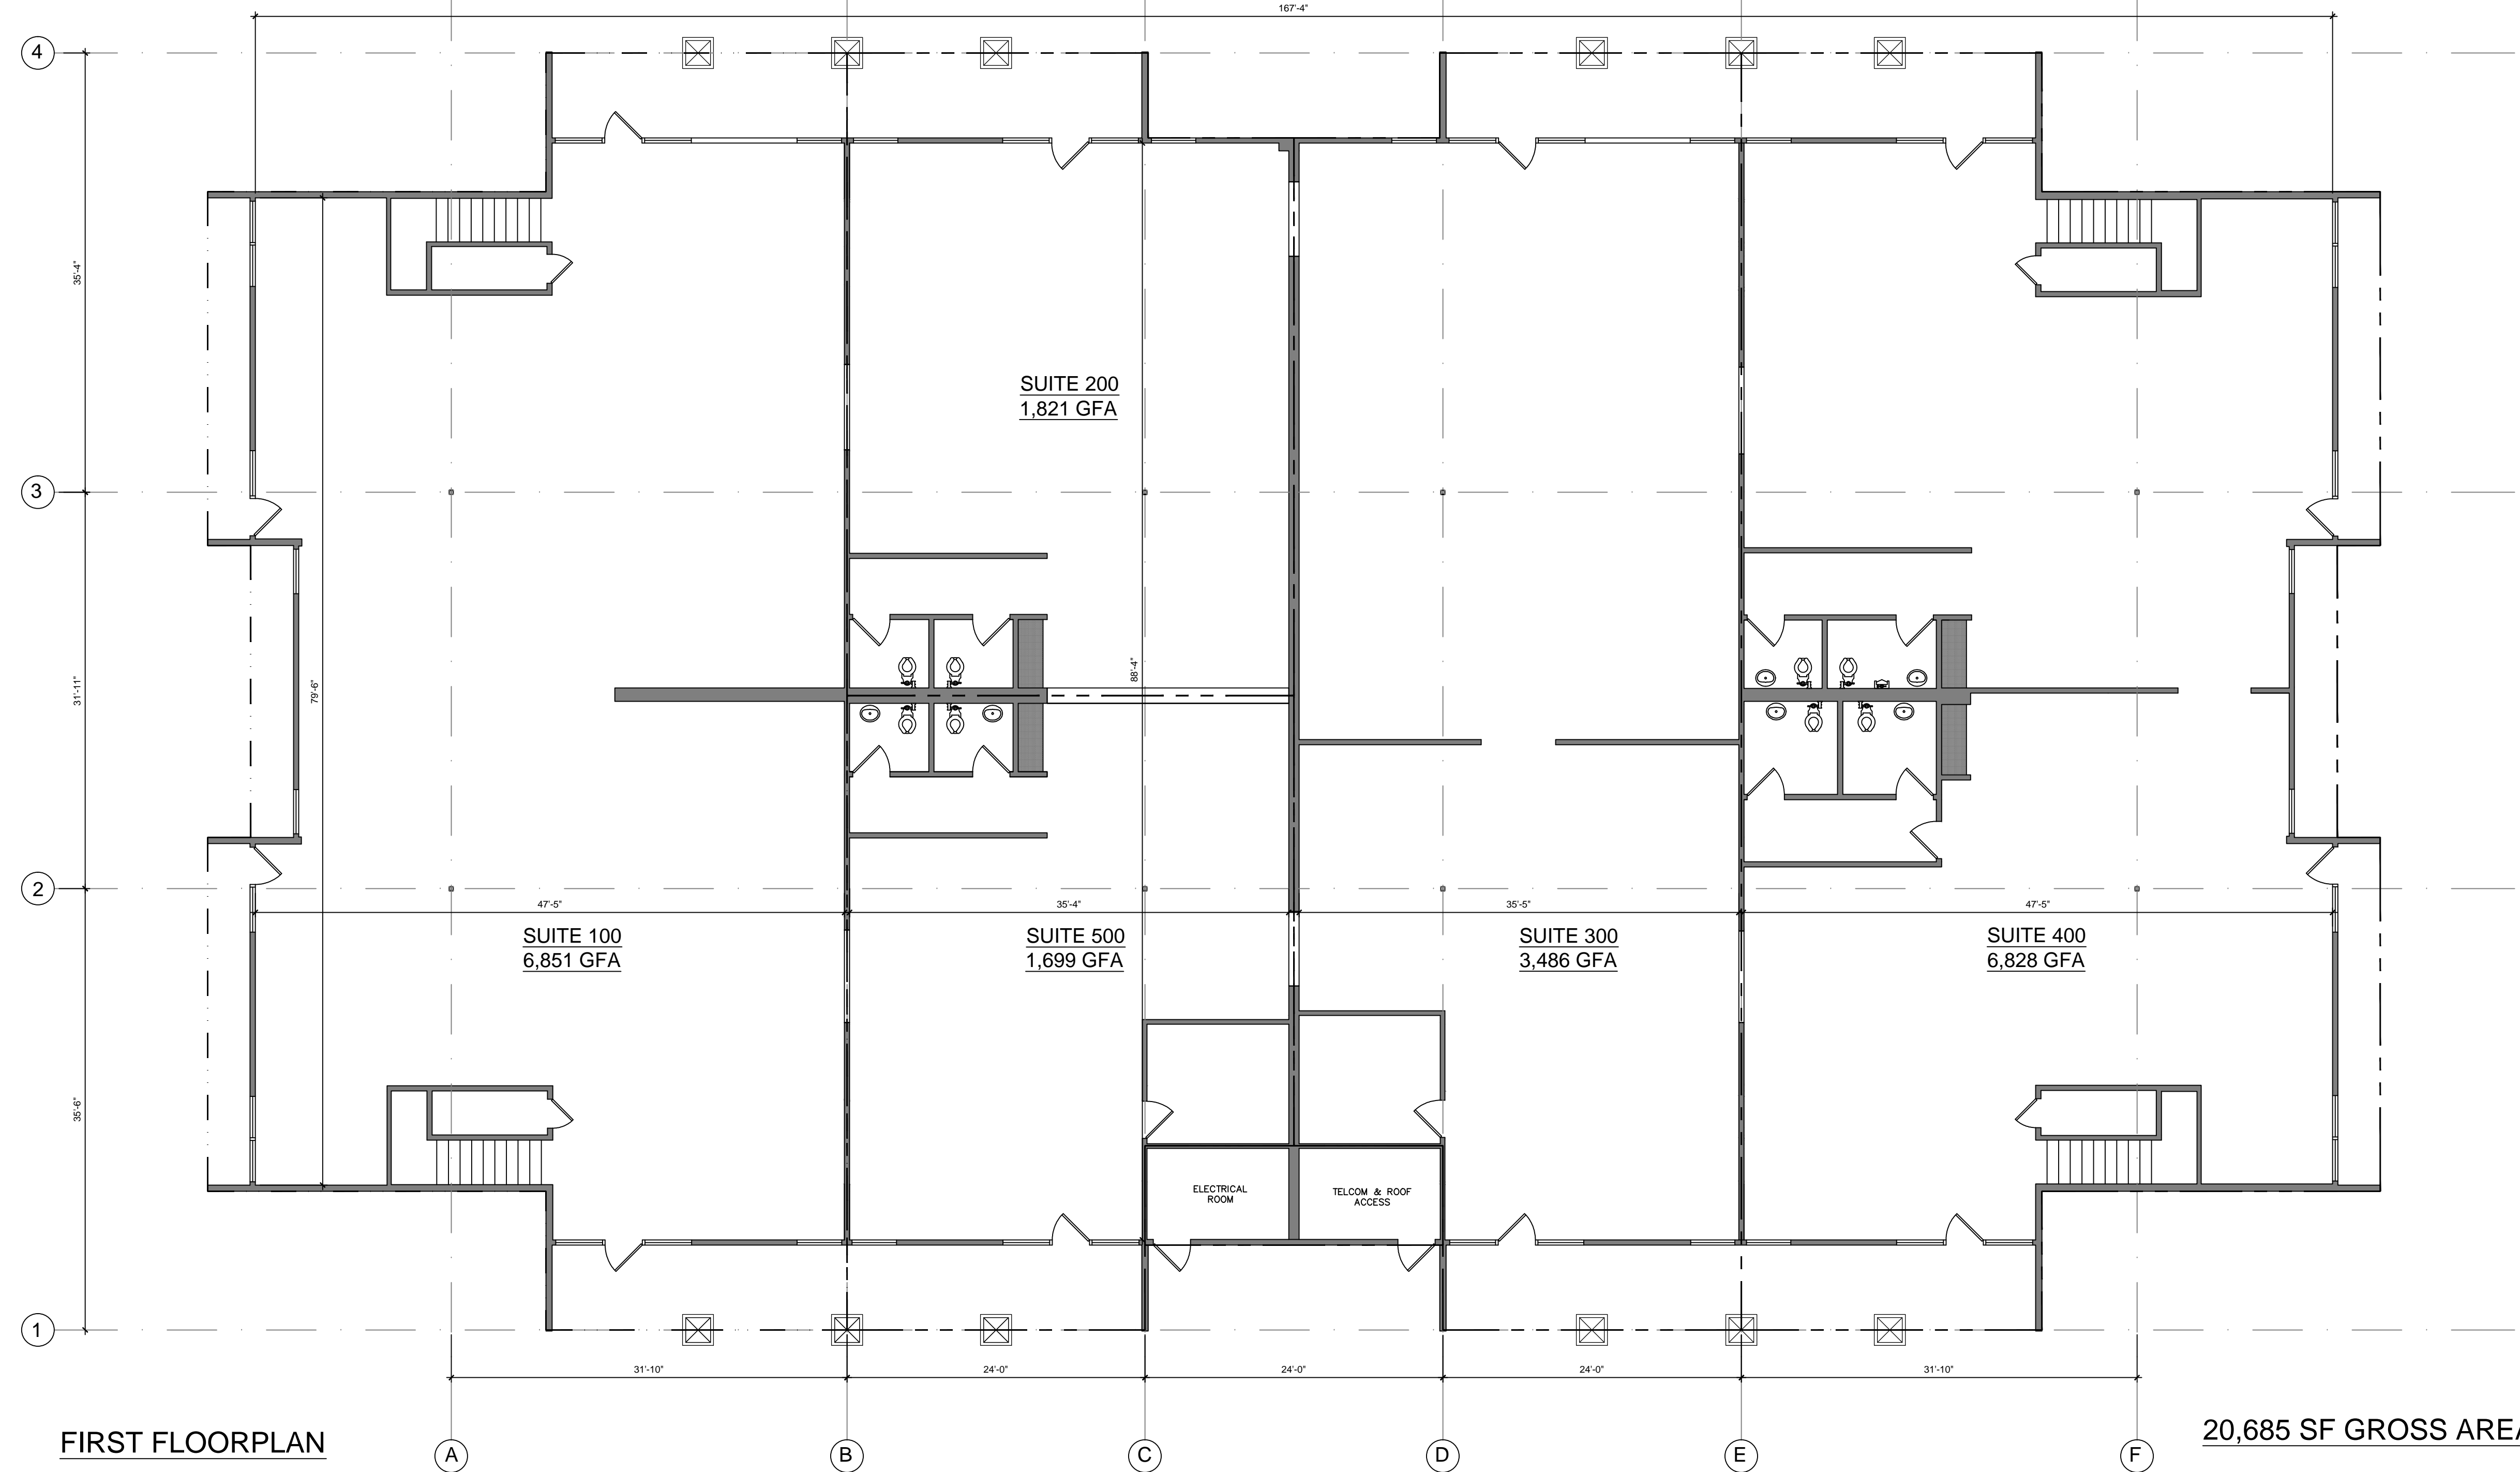


LEGEND:

Symbol	Description
	Existing Glass
	Existing Wall Construction
	Existing Door

AREA CALCULATIONS

GROSS FLOOR AREA: 20,685SF

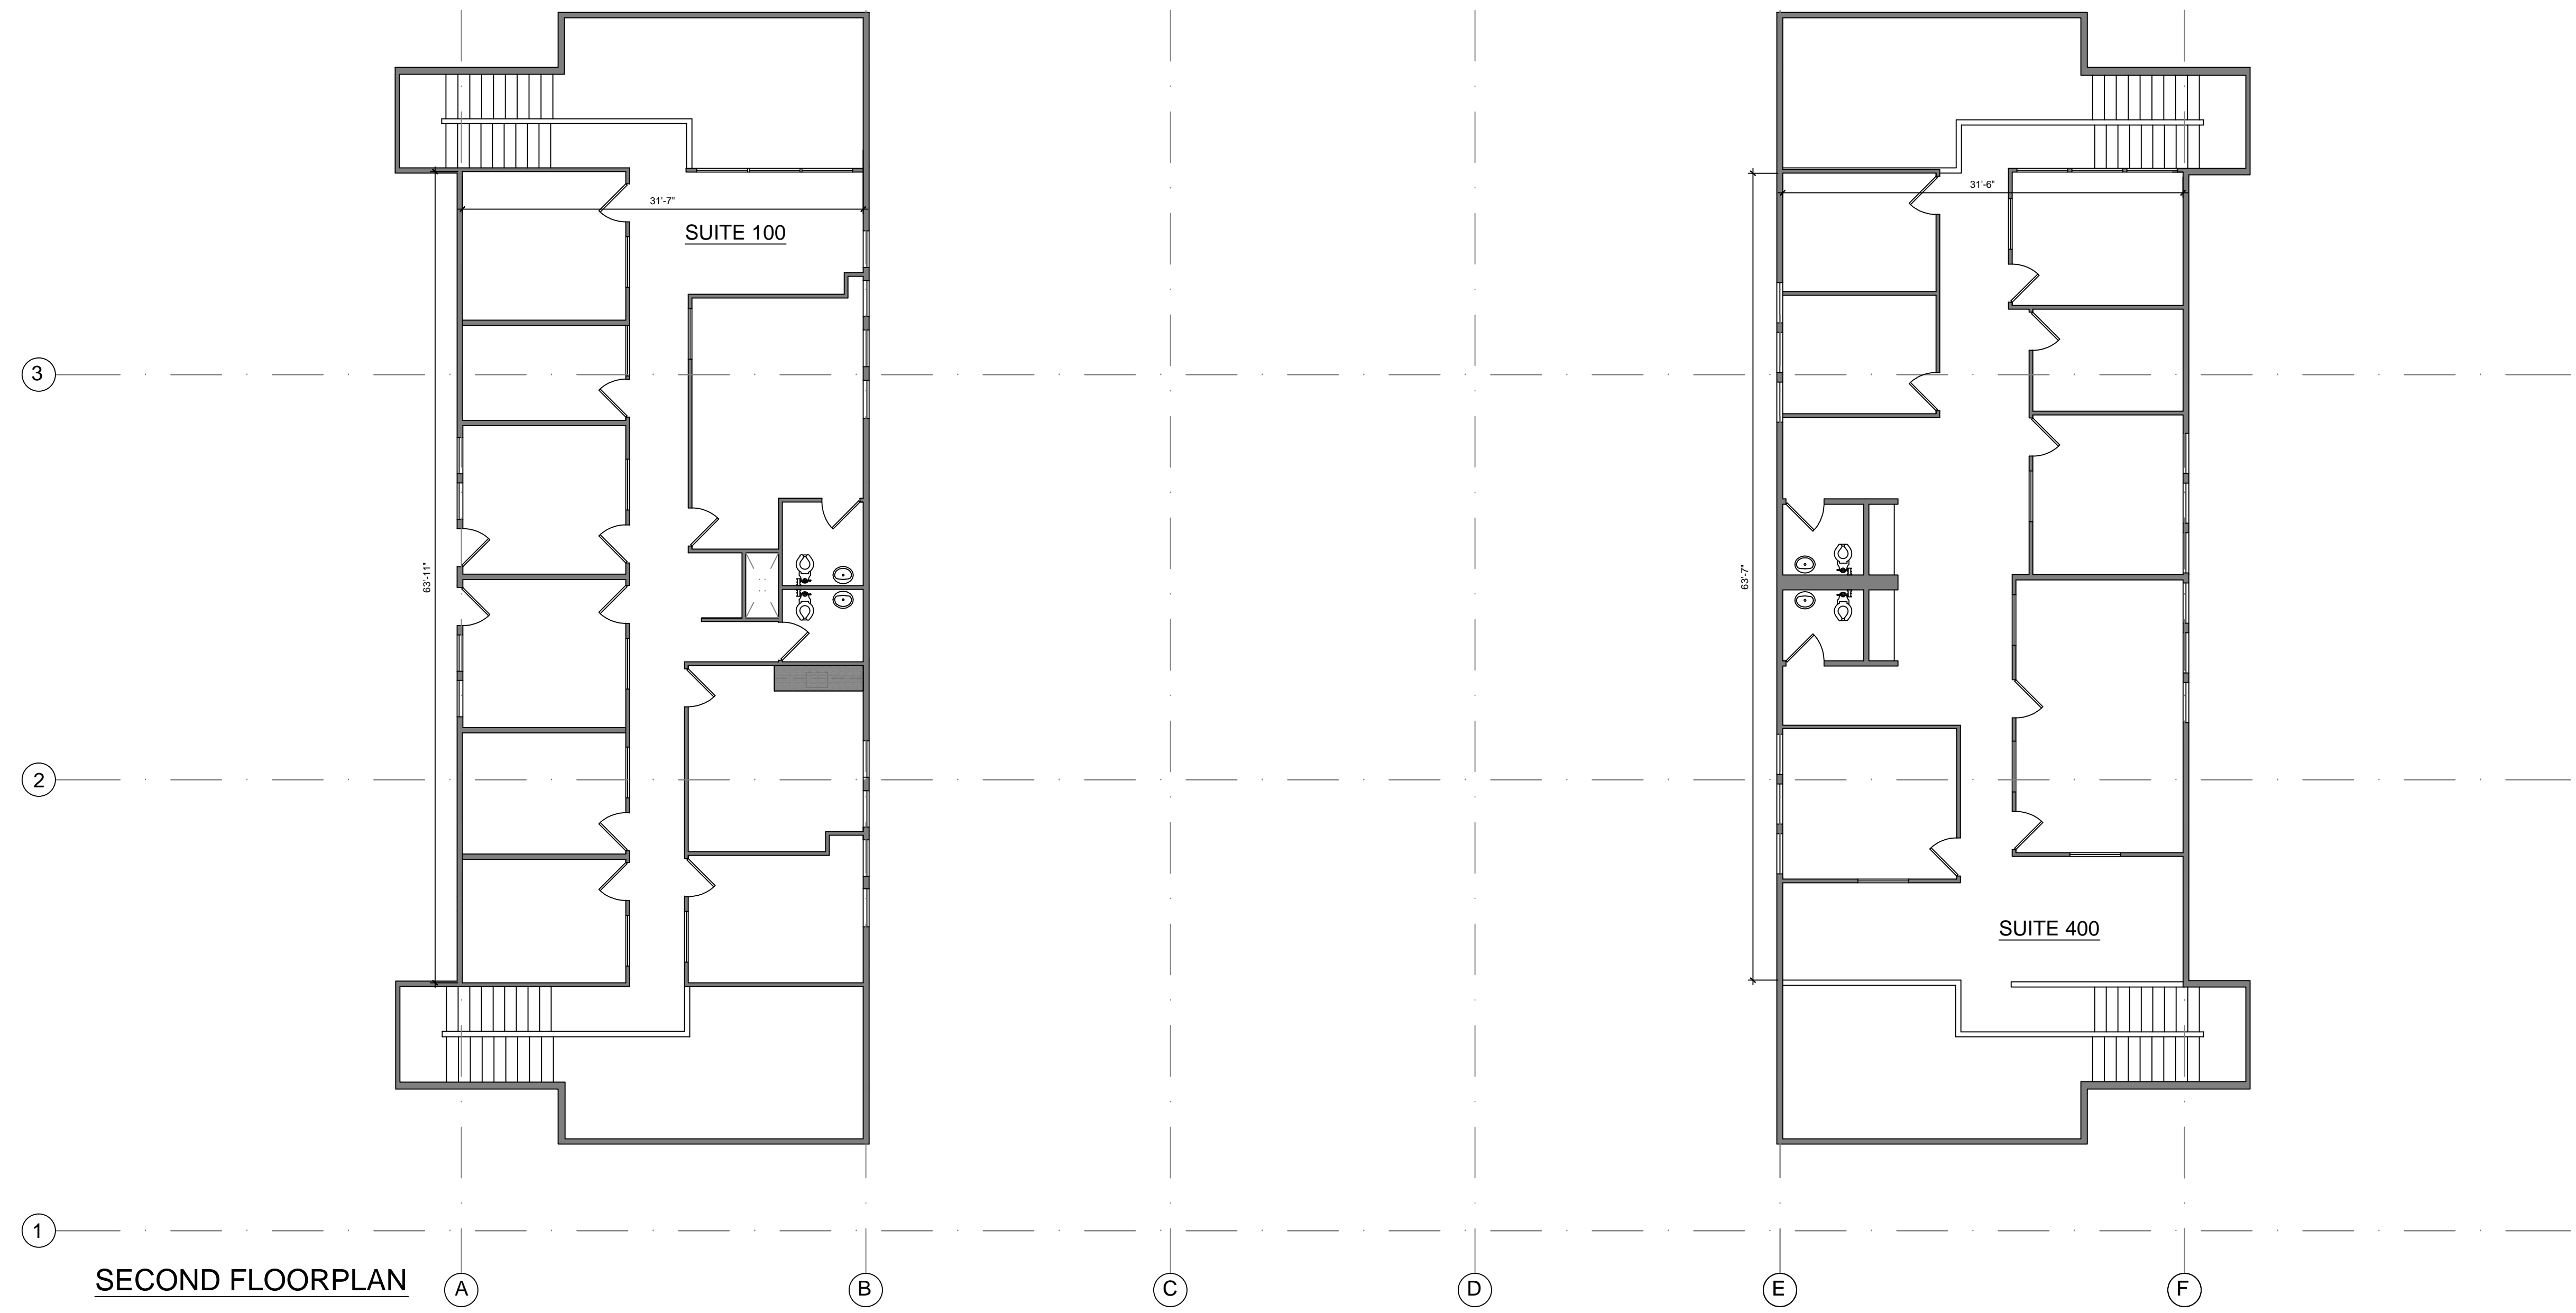


PROJECT:

BROOKHOLLOW LAKE LLC
1528 E. WARNER AVE.
SANTA ANA, CA

TENANT IMPROVEMENT

SEAL AND STAMP:

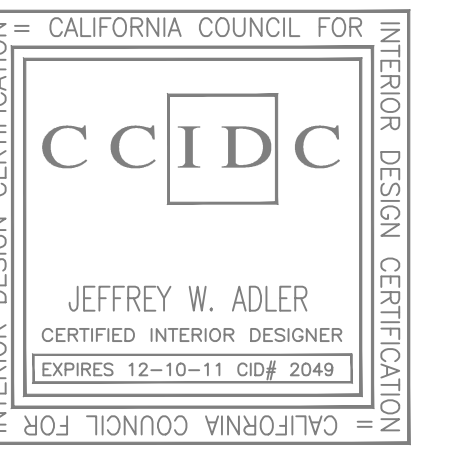

CONSULTANTS:

ISSUE DATES

No.	DATE	DESCRIPTION	BY
1	3/13/13	AS BUILTS	MM

OWNERSHIP AND USE OF DOCUMENTS

All Drawings, Specifications and Documents furnished by BOLE INTERNATIONAL, INC. are and shall remain its property. They are to be used only with respect to this project. Federal law prohibits the reproduction, display, sale, or other distribution of this document without the express written consent of BOLE INTERNATIONAL, INC.

DATE: 3-13-13

DRAWN: MM

REVIEWED: JA

PROJECT NO: AGATE

SCALE:

SHEET TITLE:

EXISTING PLANS

SHEET NO:

A1.1