
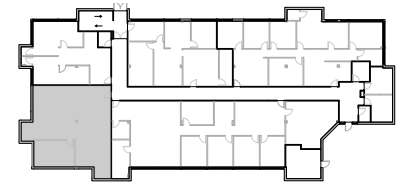


PHOENICIAN MEDICAL PLAZA

2222-2228 W NORTHERN AVE | PHOENIX, AZ 85021

C-130 | ±1,686 SF

AS-BUILT PLAN

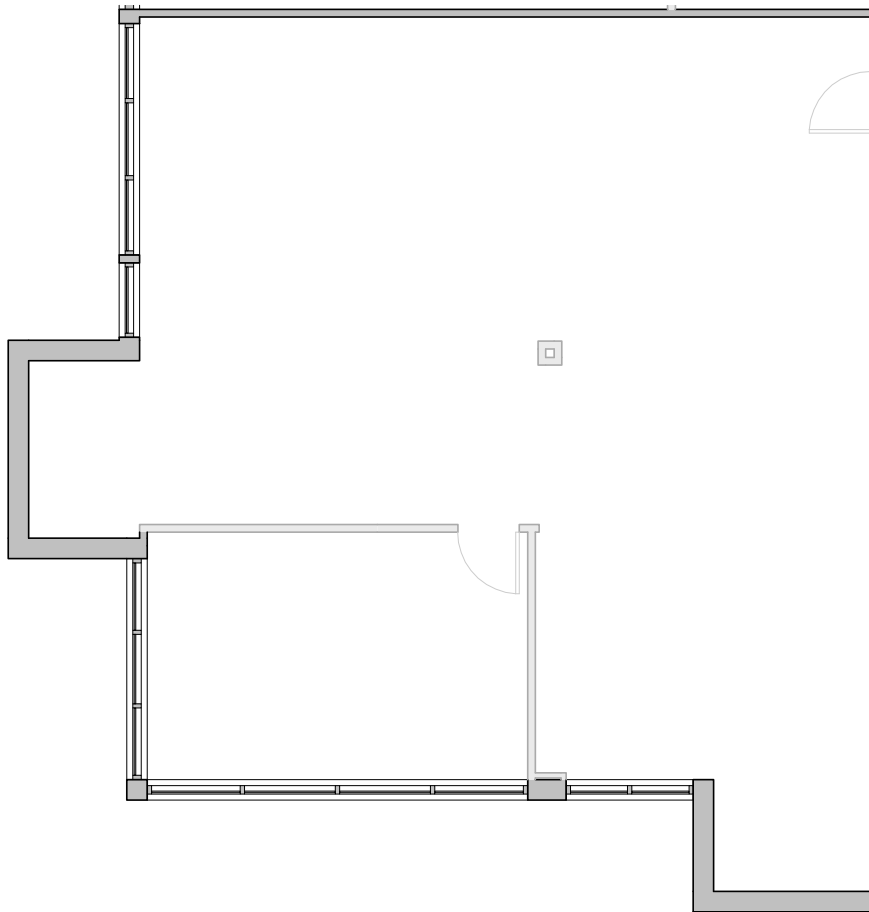

NOT TO SCALE

CONTACT:

PHILIP WURTH, CCIM

+1 602 369 9261

philip.wurth@cbre.com

ETHAN DIEDRICHSEN

+1 402 689 3895

ethan.diedrichsen@cbre.com


©2025 CBRE, Inc. All rights reserved. This information has been obtained from sources believed reliable, but has not been verified for accuracy or completeness. You should conduct a careful, independent investigation of the property and verify all information. Any reliance on this information is solely at your own risk. CBRE and the CBRE logo are service marks of CBRE, Inc. All other marks displayed on this document are the property of their respective owners, and the use of such logos does not imply any affiliation with or endorsement of CBRE. Photos herein are the property of their respective owners. Use of these images without the express written consent of the owner is prohibited.

CBRE

PHOENICIAN MEDICAL PLAZA

2222-2228 W NORTHERN AVE | PHOENIX, AZ 85021

C-130 | ±1,686 SF
CONCEPTUAL PLAN

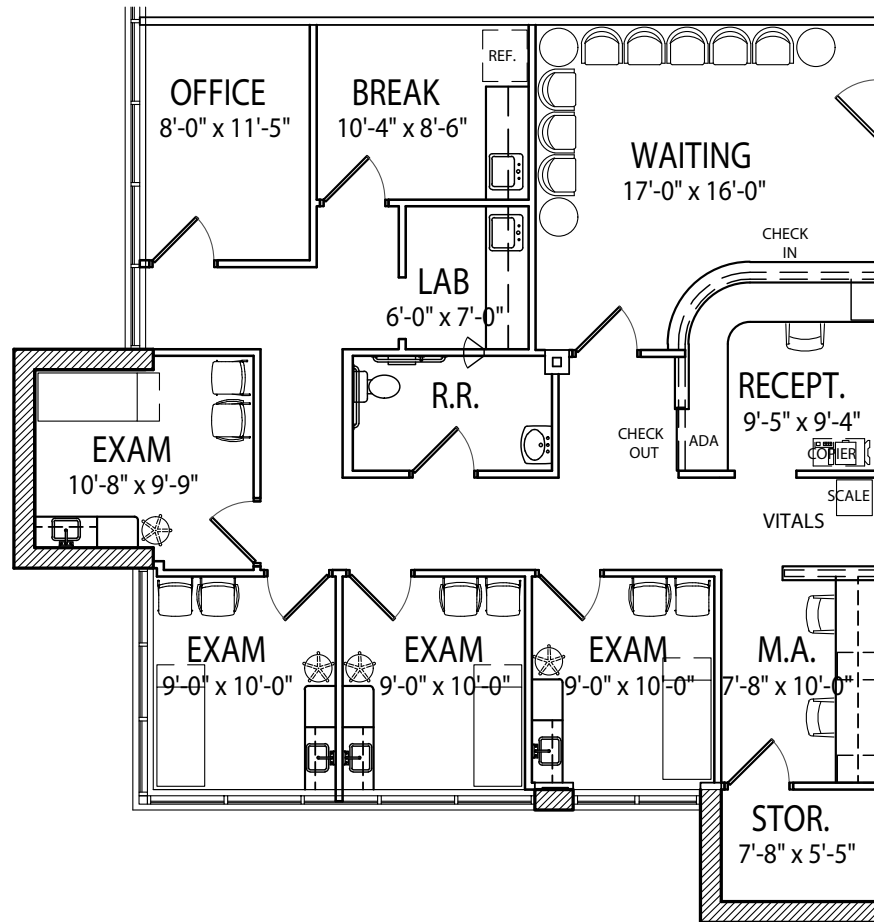

NOT TO SCALE

CONTACT:

PHILIP WURTH, CCIM

+1 602 369 9261

philip.wurth@cbre.com

ETHAN DIEDRICHSEN

+1 402 689 3895

ethan.diedrichsen@cbre.com


©2025 CBRE, Inc. All rights reserved. This information has been obtained from sources believed reliable, but has not been verified for accuracy or completeness. You should conduct a careful, independent investigation of the property and verify all information. Any reliance on this information is solely at your own risk. CBRE and the CBRE logo are service marks of CBRE, Inc. All other marks displayed on this document are the property of their respective owners, and the use of such logos does not imply any affiliation with or endorsement of CBRE. Photos herein are the property of their respective owners. Use of these images without the express written consent of the owner is prohibited.

CBRE

PHOENICIAN MEDICAL PLAZA

2222-2228 W NORTHERN AVE | PHOENIX, AZ 85021

C-140 | ±3,448 SF
AS-BUILT PLAN

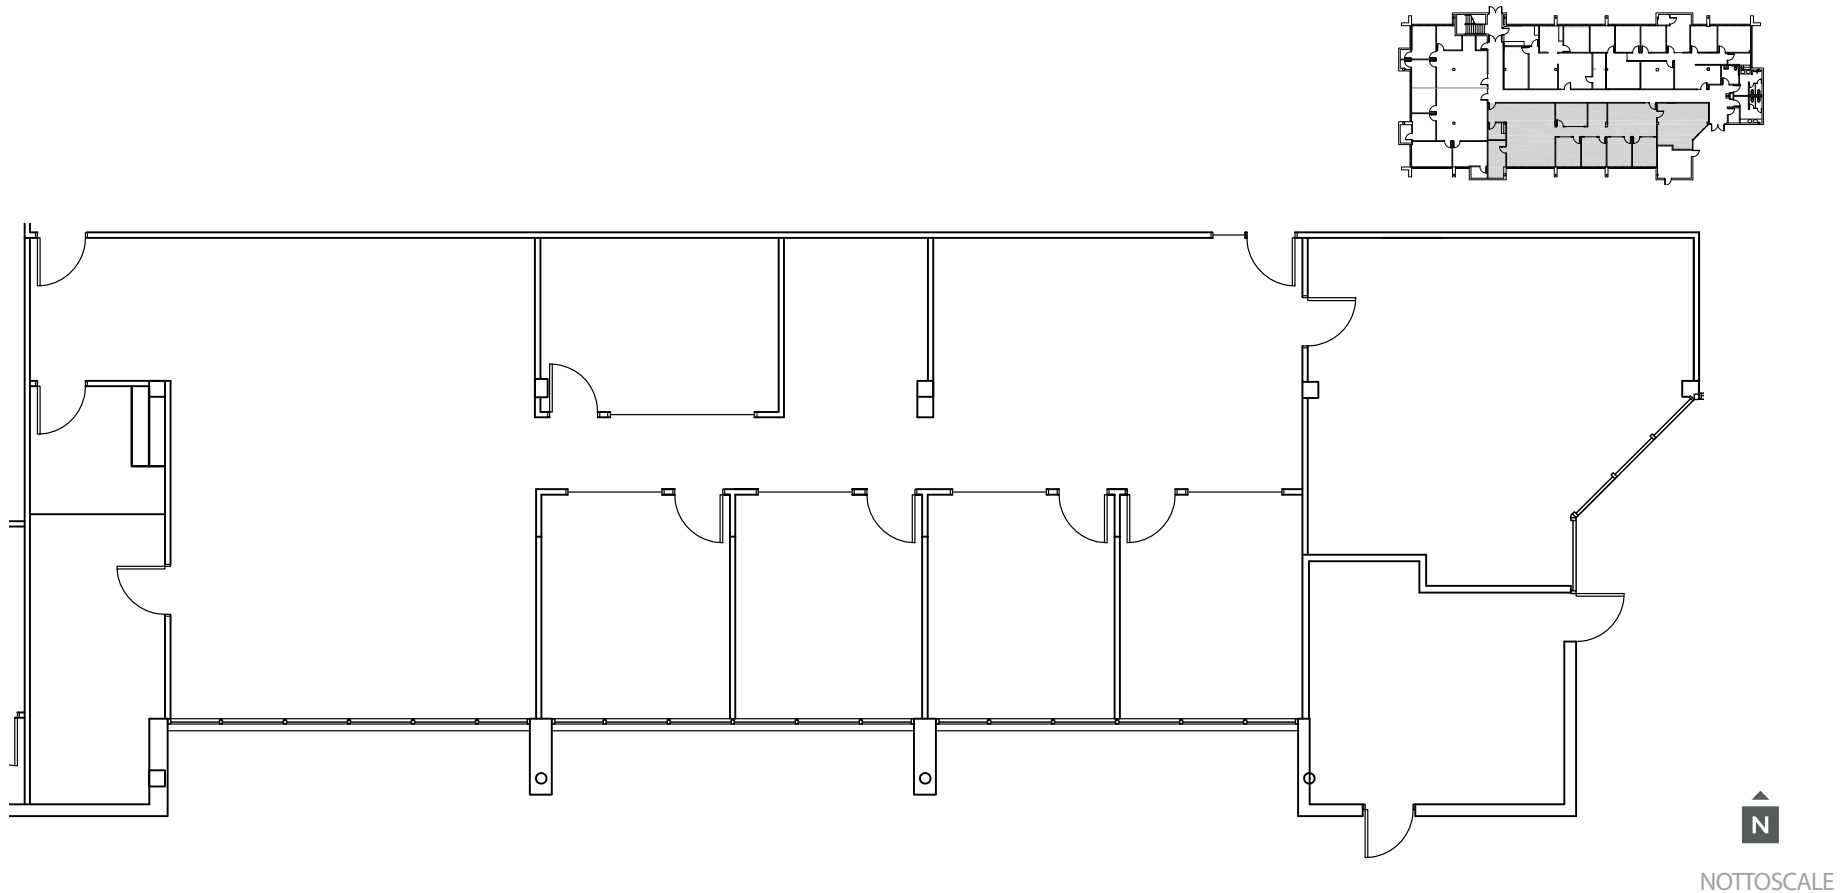

CONTACT:

PHILIP WURTH, CCIM

+1 602 369 9261

philip.wurth@cbre.com

ETHAN DIEDRICHSEN

+1 402 689 3895

ethan.diedrichsen@cbre.com

©2025 CBRE, Inc. All rights reserved. This information has been obtained from sources believed reliable, but has not been verified for accuracy or completeness. You should conduct a careful, independent investigation of the property and verify all information. Any reliance on this information is solely at your own risk. CBRE and the CBRE logo are service marks of CBRE, Inc. All other marks displayed on this document are the property of their respective owners, and the use of such logos does not imply any affiliation with or endorsement of CBRE. Photos herein are the property of their respective owners. Use of these images without the express written consent of the owner is prohibited.



CBRE

PHOENICIAN MEDICAL PLAZA

2222-2228 W NORTHERN AVE | PHOENIX, AZ 85021

C-140 | ±3,448 SF
CONCEPTUAL PLAN

CLICK HERE

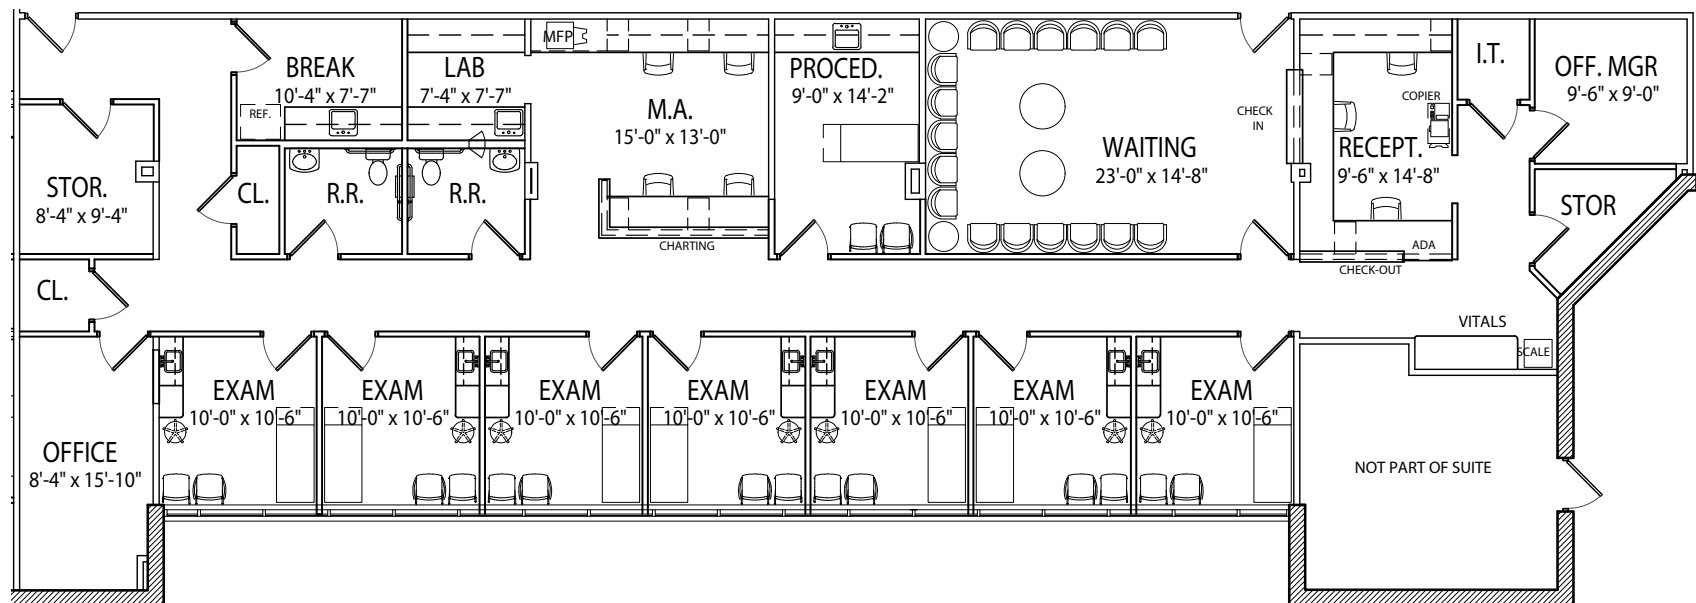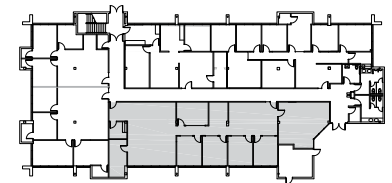

N
NOT TO SCALE

CONTACT:

PHILIP WURTH, CCIM

+1 602 369 9261

philip.wurth@cbre.com

ETHAN DIEDRICHSEN

+1 402 689 3895

ethan.diedrichsen@cbre.com


©2025 CBRE, Inc. All rights reserved. This information has been obtained from sources believed reliable, but has not been verified for accuracy or completeness. You should conduct a careful, independent investigation of the property and verify all information. Any reliance on this information is solely at your own risk. CBRE and the CBRE logo are service marks of CBRE, Inc. All other marks displayed on this document are the property of their respective owners, and the use of such logos does not imply any affiliation with or endorsement of CBRE. Photos herein are the property of their respective owners. Use of these images without the express written consent of the owner is prohibited.

CBRE

PHOENICIAN MEDICAL PLAZA

2222-2228 W NORTHERN AVE | PHOENIX, AZ 85021

C-130/140 | ±5,135 SF
CONCEPTUAL PLAN

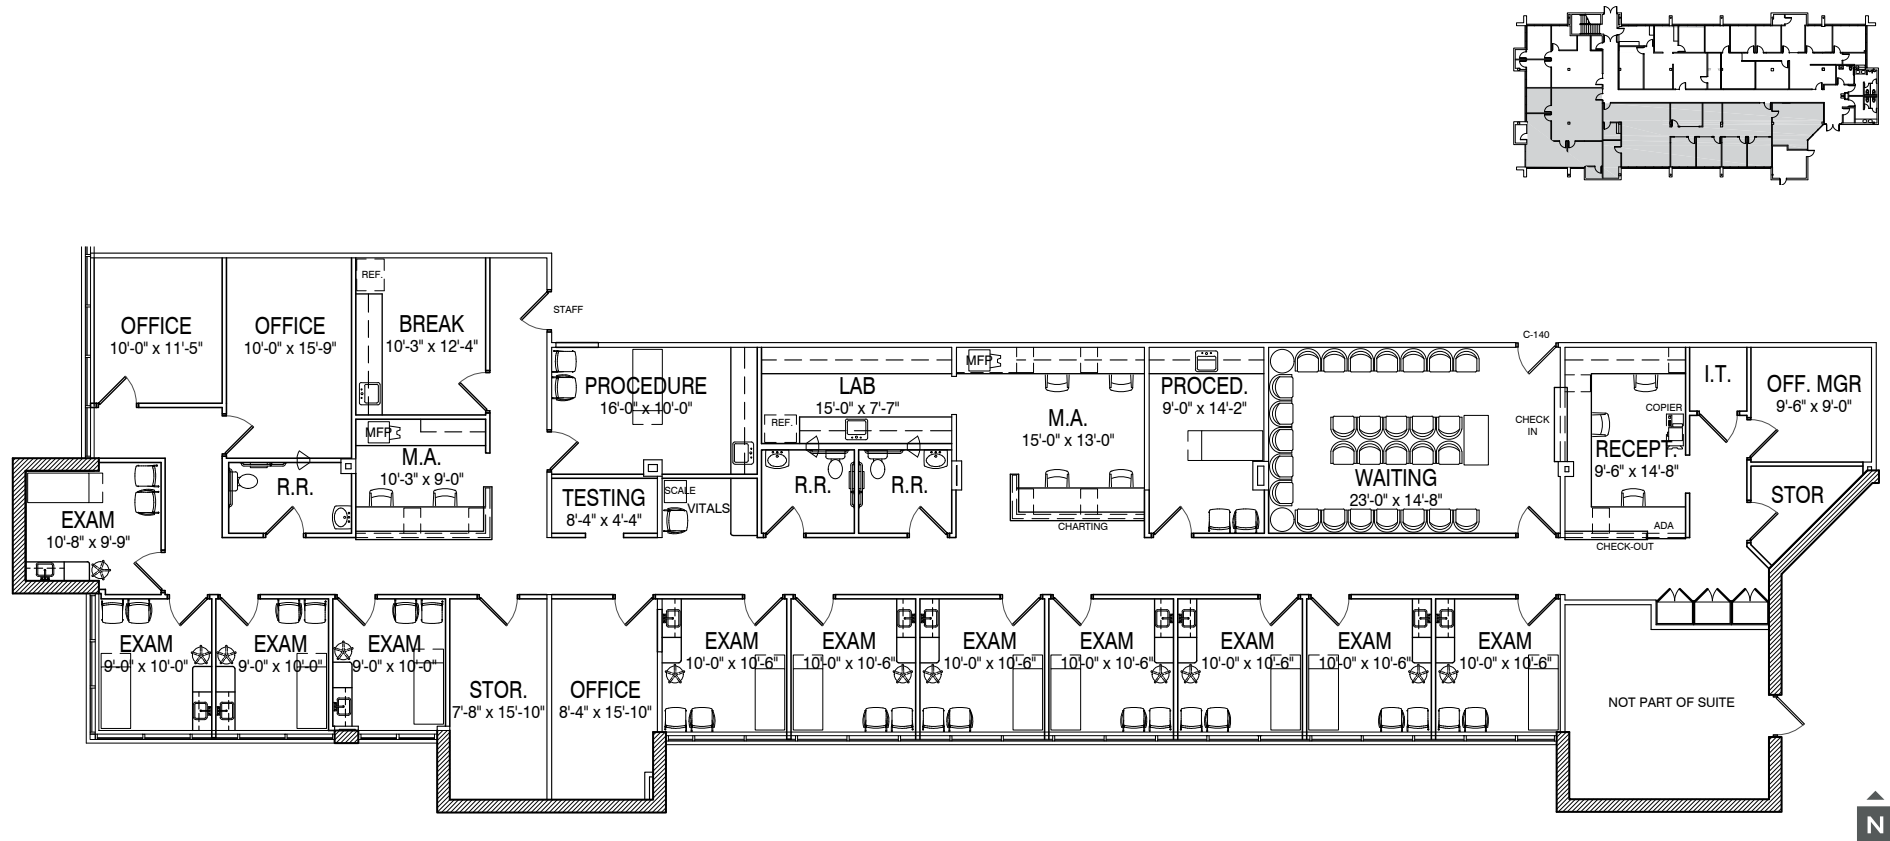

CONTACT:

PHILIP WURTH, CCIM
+1 602 369 9261
philip.wurth@cbre.com

ETHAN DIEDRICHSEN
+1 402 689 3895
ethan.diedrichsen@cbre.com


©2025 CBRE, Inc. All rights reserved. This information has been obtained from sources believed reliable, but has not been verified for accuracy or completeness. You should conduct a careful, independent investigation of the property and verify all information. Any reliance on this information is solely at your own risk. CBRE and the CBRE logo are service marks of CBRE, Inc. All other marks displayed on this document are the property of their respective owners, and the use of such logos does not imply any affiliation with or endorsement of CBRE. Photos herein are the property of their respective owners. Use of these images without the express written consent of the owner is prohibited.

CBRE

PHOENICIAN MEDICAL PLAZA

2222-2228 W NORTHERN AVE | PHOENIX, AZ 85021

D-100 | ±3,560 SF
CONCEPTUAL PLAN

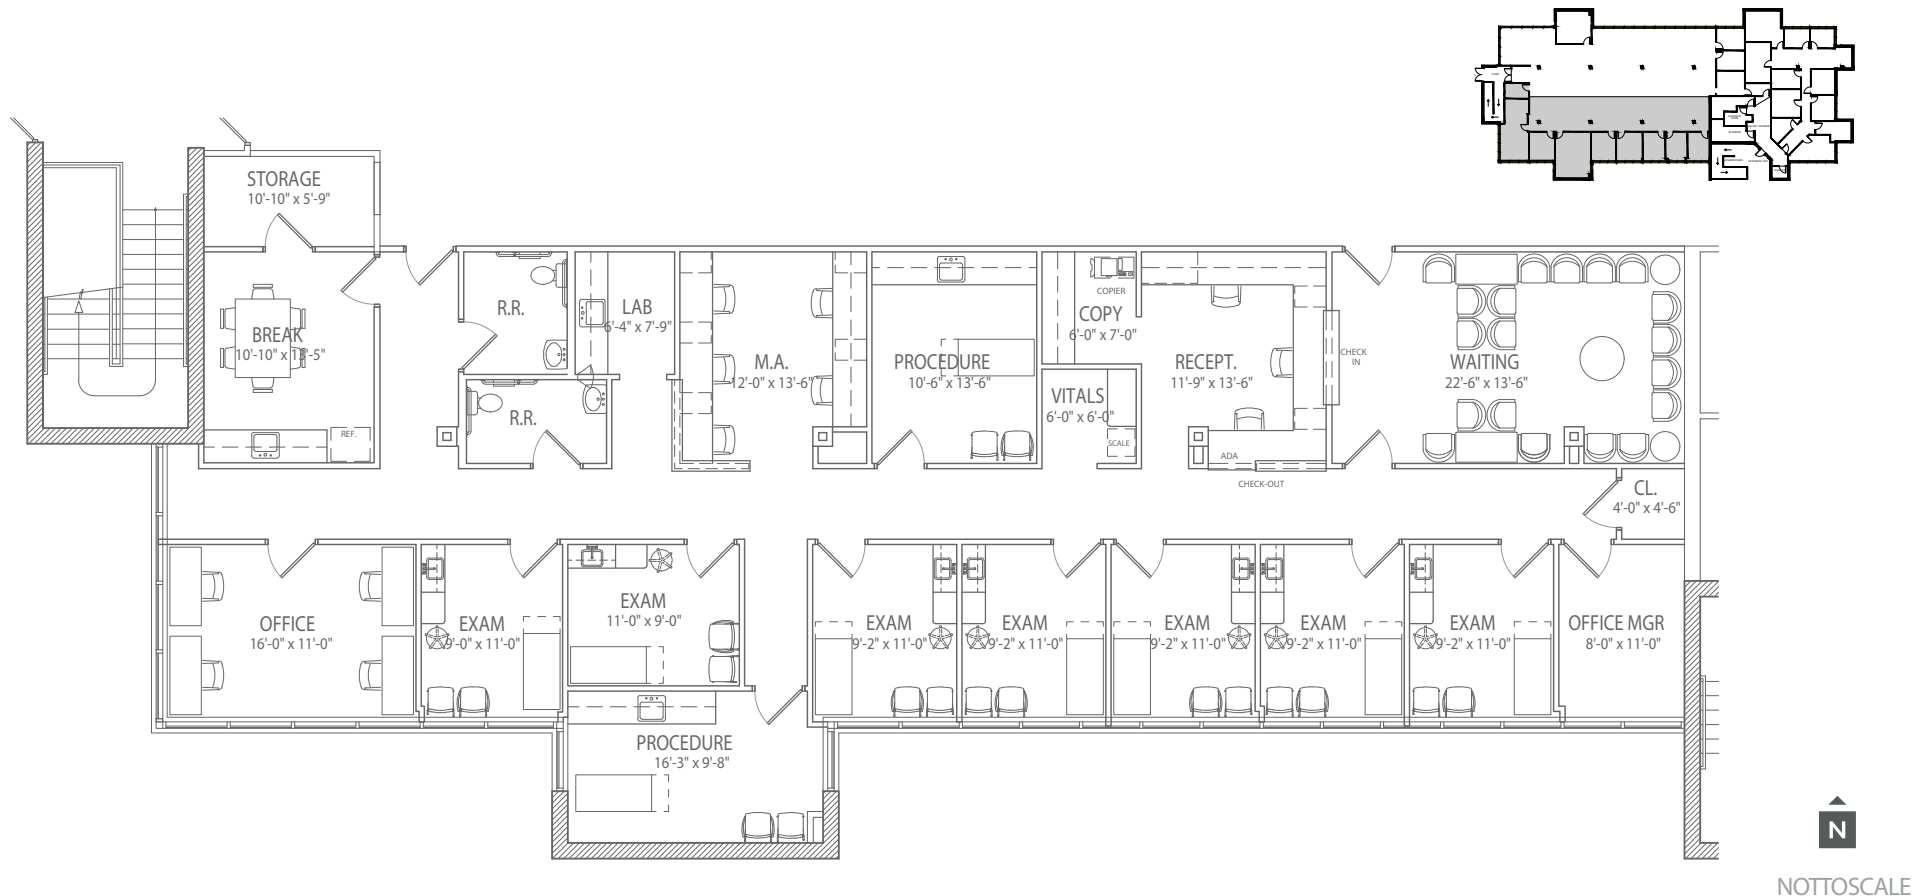

CONTACT:

PHILIP WURTH, CCIM
+1 602 369 9261
philip.wurth@cbre.com

ETHAN DIEDRICHSEN
+1 402 689 3895
ethan.diedrichsen@cbre.com


©2025 CBRE, Inc. All rights reserved. This information has been obtained from sources believed reliable, but has not been verified for accuracy or completeness. You should conduct a careful, independent investigation of the property and verify all information. Any reliance on this information is solely at your own risk. CBRE and the CBRE logo are service marks of CBRE, Inc. All other marks displayed on this document are the property of their respective owners, and the use of such logos does not imply any affiliation with or endorsement of CBRE. Photos herein are the property of their respective owners. Use of these images without the express written consent of the owner is prohibited.

CBRE

PHOENICIAN MEDICAL PLAZA

2222-2228 W NORTHERN AVE | PHOENIX, AZ 85021

D-110 | ±1,747 SF
CONCEPTUAL PLAN

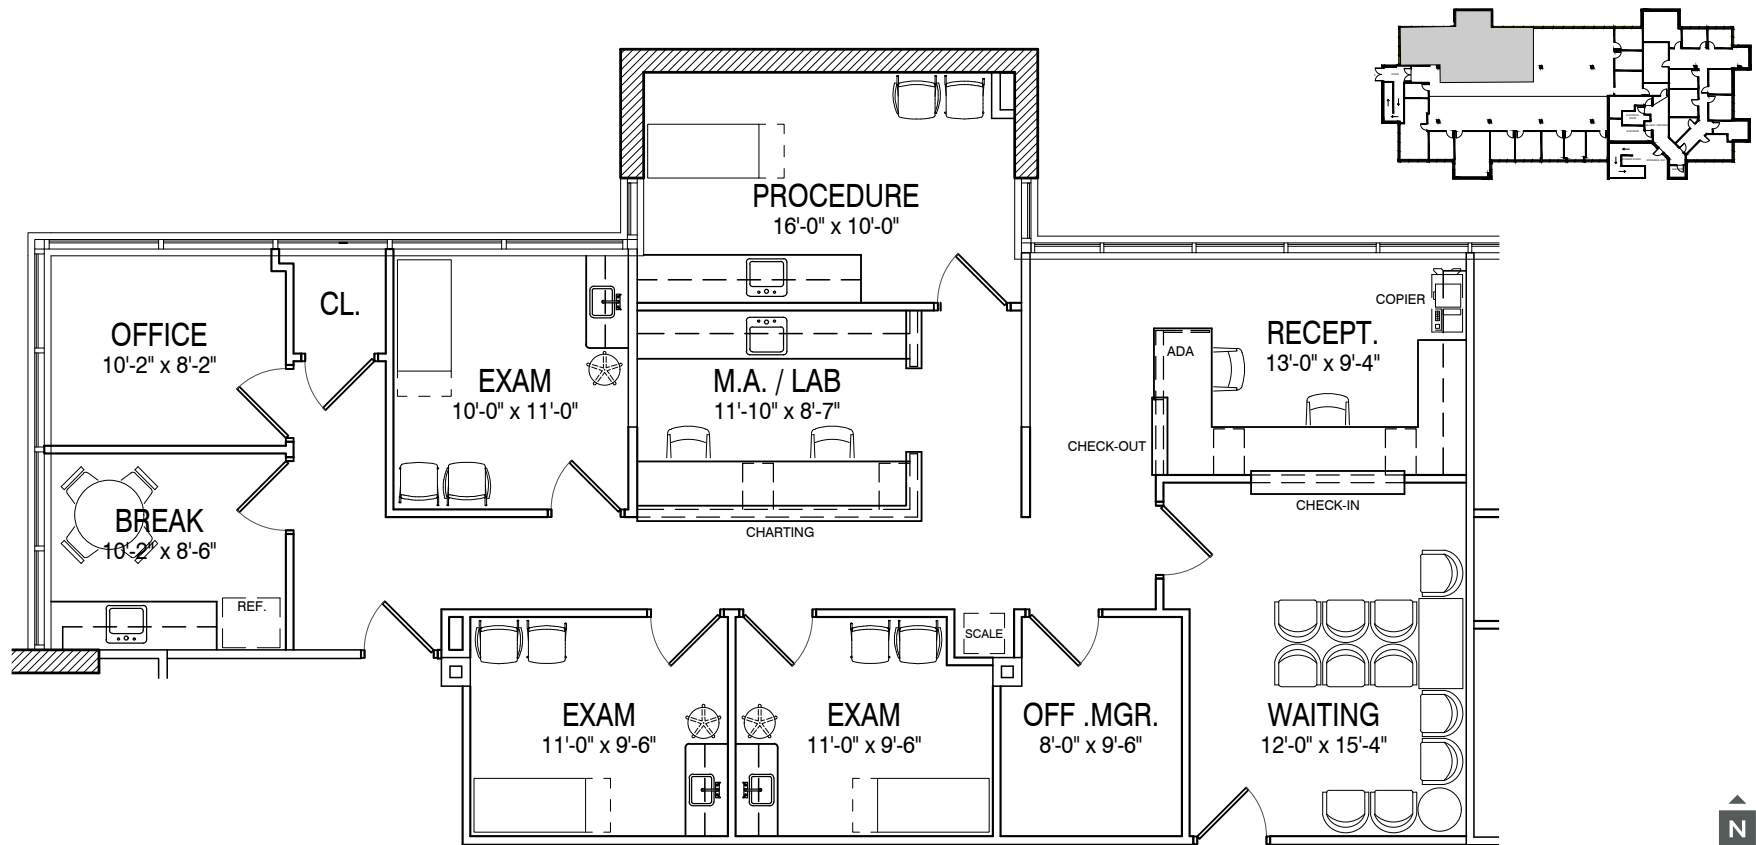

CONTACT:

PHILIP WURTH, CCIM

+1 602 369 9261

philip.wurth@cbre.com

ETHAN DIEDRICHSEN

+1 402 689 3895

ethan.diedrichsen@cbre.com

©2025 CBRE, Inc. All rights reserved. This information has been obtained from sources believed reliable, but has not been verified for accuracy or completeness. You should conduct a careful, independent investigation of the property and verify all information. Any reliance on this information is solely at your own risk. CBRE and the CBRE logo are service marks of CBRE, Inc. All other marks displayed on this document are the property of their respective owners, and the use of such logos does not imply any affiliation with or endorsement of CBRE. Photos herein are the property of their respective owners. Use of these images without the express written consent of the owner is prohibited.


CBRE

PHOENICIAN MEDICAL PLAZA

2222-2228 W NORTHERN AVE | PHOENIX, AZ 85021

D-265 | ±2,146 SF

CLICK HERE

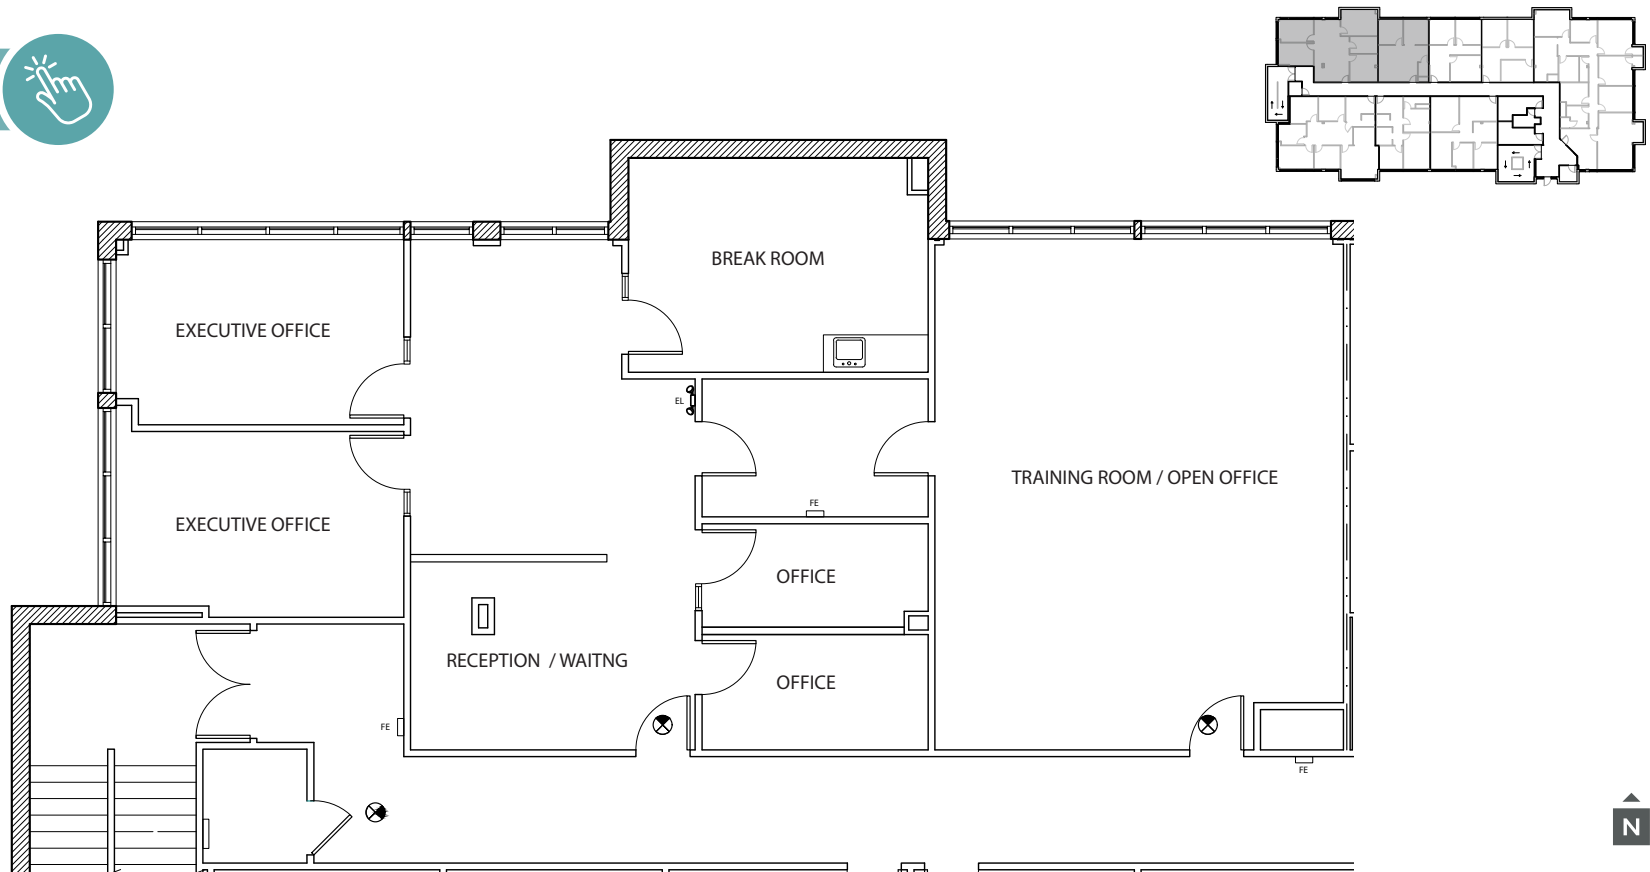

CONTACT:

PHILIP WURTH, CCIM

+1 602 369 9261

philip.wurth@cbre.com

ETHAN DIEDRICHSEN

+1 402 689 3895

ethan.diedrichsen@cbre.com



©2025 CBRE, Inc. All rights reserved. This information has been obtained from sources believed reliable, but has not been verified for accuracy or completeness. You should conduct a careful, independent investigation of the property and verify all information. Any reliance on this information is solely at your own risk. CBRE and the CBRE logo are service marks of CBRE, Inc. All other marks displayed on this document are the property of their respective owners, and the use of such logos does not imply any affiliation with or endorsement of CBRE. Photos herein are the property of their respective owners. Use of these images without the express written consent of the owner is prohibited.

CBRE

PHOENICIAN MEDICAL PLAZA

2222-2228 W NORTHERN AVE | PHOENIX, AZ 85021

D-270 | ±1,698 SF

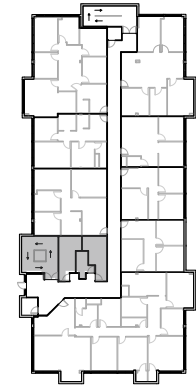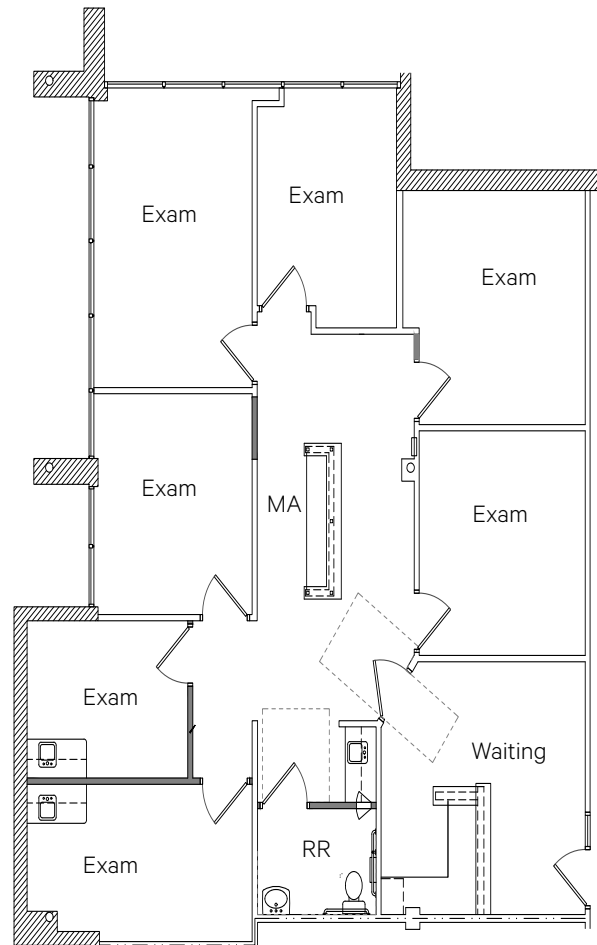

NOT TO SCALE

CONTACT:

PHILIP WURTH, CCIM

+1 602 369 9261

philip.wurth@cbre.com

ETHAN DIEDRICHSEN

+1 402 689 3895

ethan.diedrichsen@cbre.com


©2025 CBRE, Inc. All rights reserved. This information has been obtained from sources believed reliable, but has not been verified for accuracy or completeness. You should conduct a careful, independent investigation of the property and verify all information. Any reliance on this information is solely at your own risk. CBRE and the CBRE logo are service marks of CBRE, Inc. All other marks displayed on this document are the property of their respective owners, and the use of such logos does not imply any affiliation with or endorsement of CBRE. Photos herein are the property of their respective owners. Use of these images without the express written consent of the owner is prohibited.

CBRE

PHOENICIAN MEDICAL PLAZA

2222-2228 W NORTHERN AVE | PHOENIX, AZ 85021

D-270 | ±1,698 SF

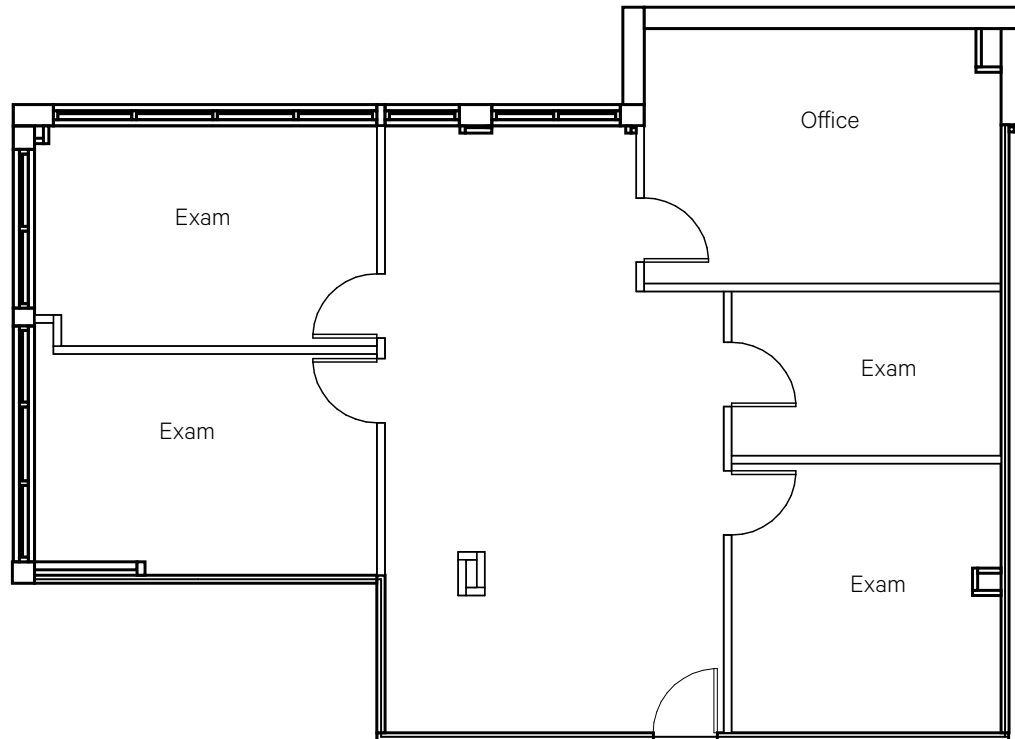

NOT TO SCALE

CONTACT:

PHILIP WURTH, CCIM

+1 602 369 9261

philip.wurth@cbre.com

ETHAN DIEDRICHSEN

+1 402 689 3895

ethan.diedrichsen@cbre.com

©2025 CBRE, Inc. All rights reserved. This information has been obtained from sources believed reliable, but has not been verified for accuracy or completeness. You should conduct a careful, independent investigation of the property and verify all information. Any reliance on this information is solely at your own risk. CBRE and the CBRE logo are service marks of CBRE, Inc. All other marks displayed on this document are the property of their respective owners, and the use of such logos does not imply any affiliation with or endorsement of CBRE. Photos herein are the property of their respective owners. Use of these images without the express written consent of the owner is prohibited.

CBRE