


18,033 SF combined

# 7 Cambridge Drive Trumbull, CT 06611

Part 2<sup>nd</sup> Floor approx. 25,526 SF  
(as-built)

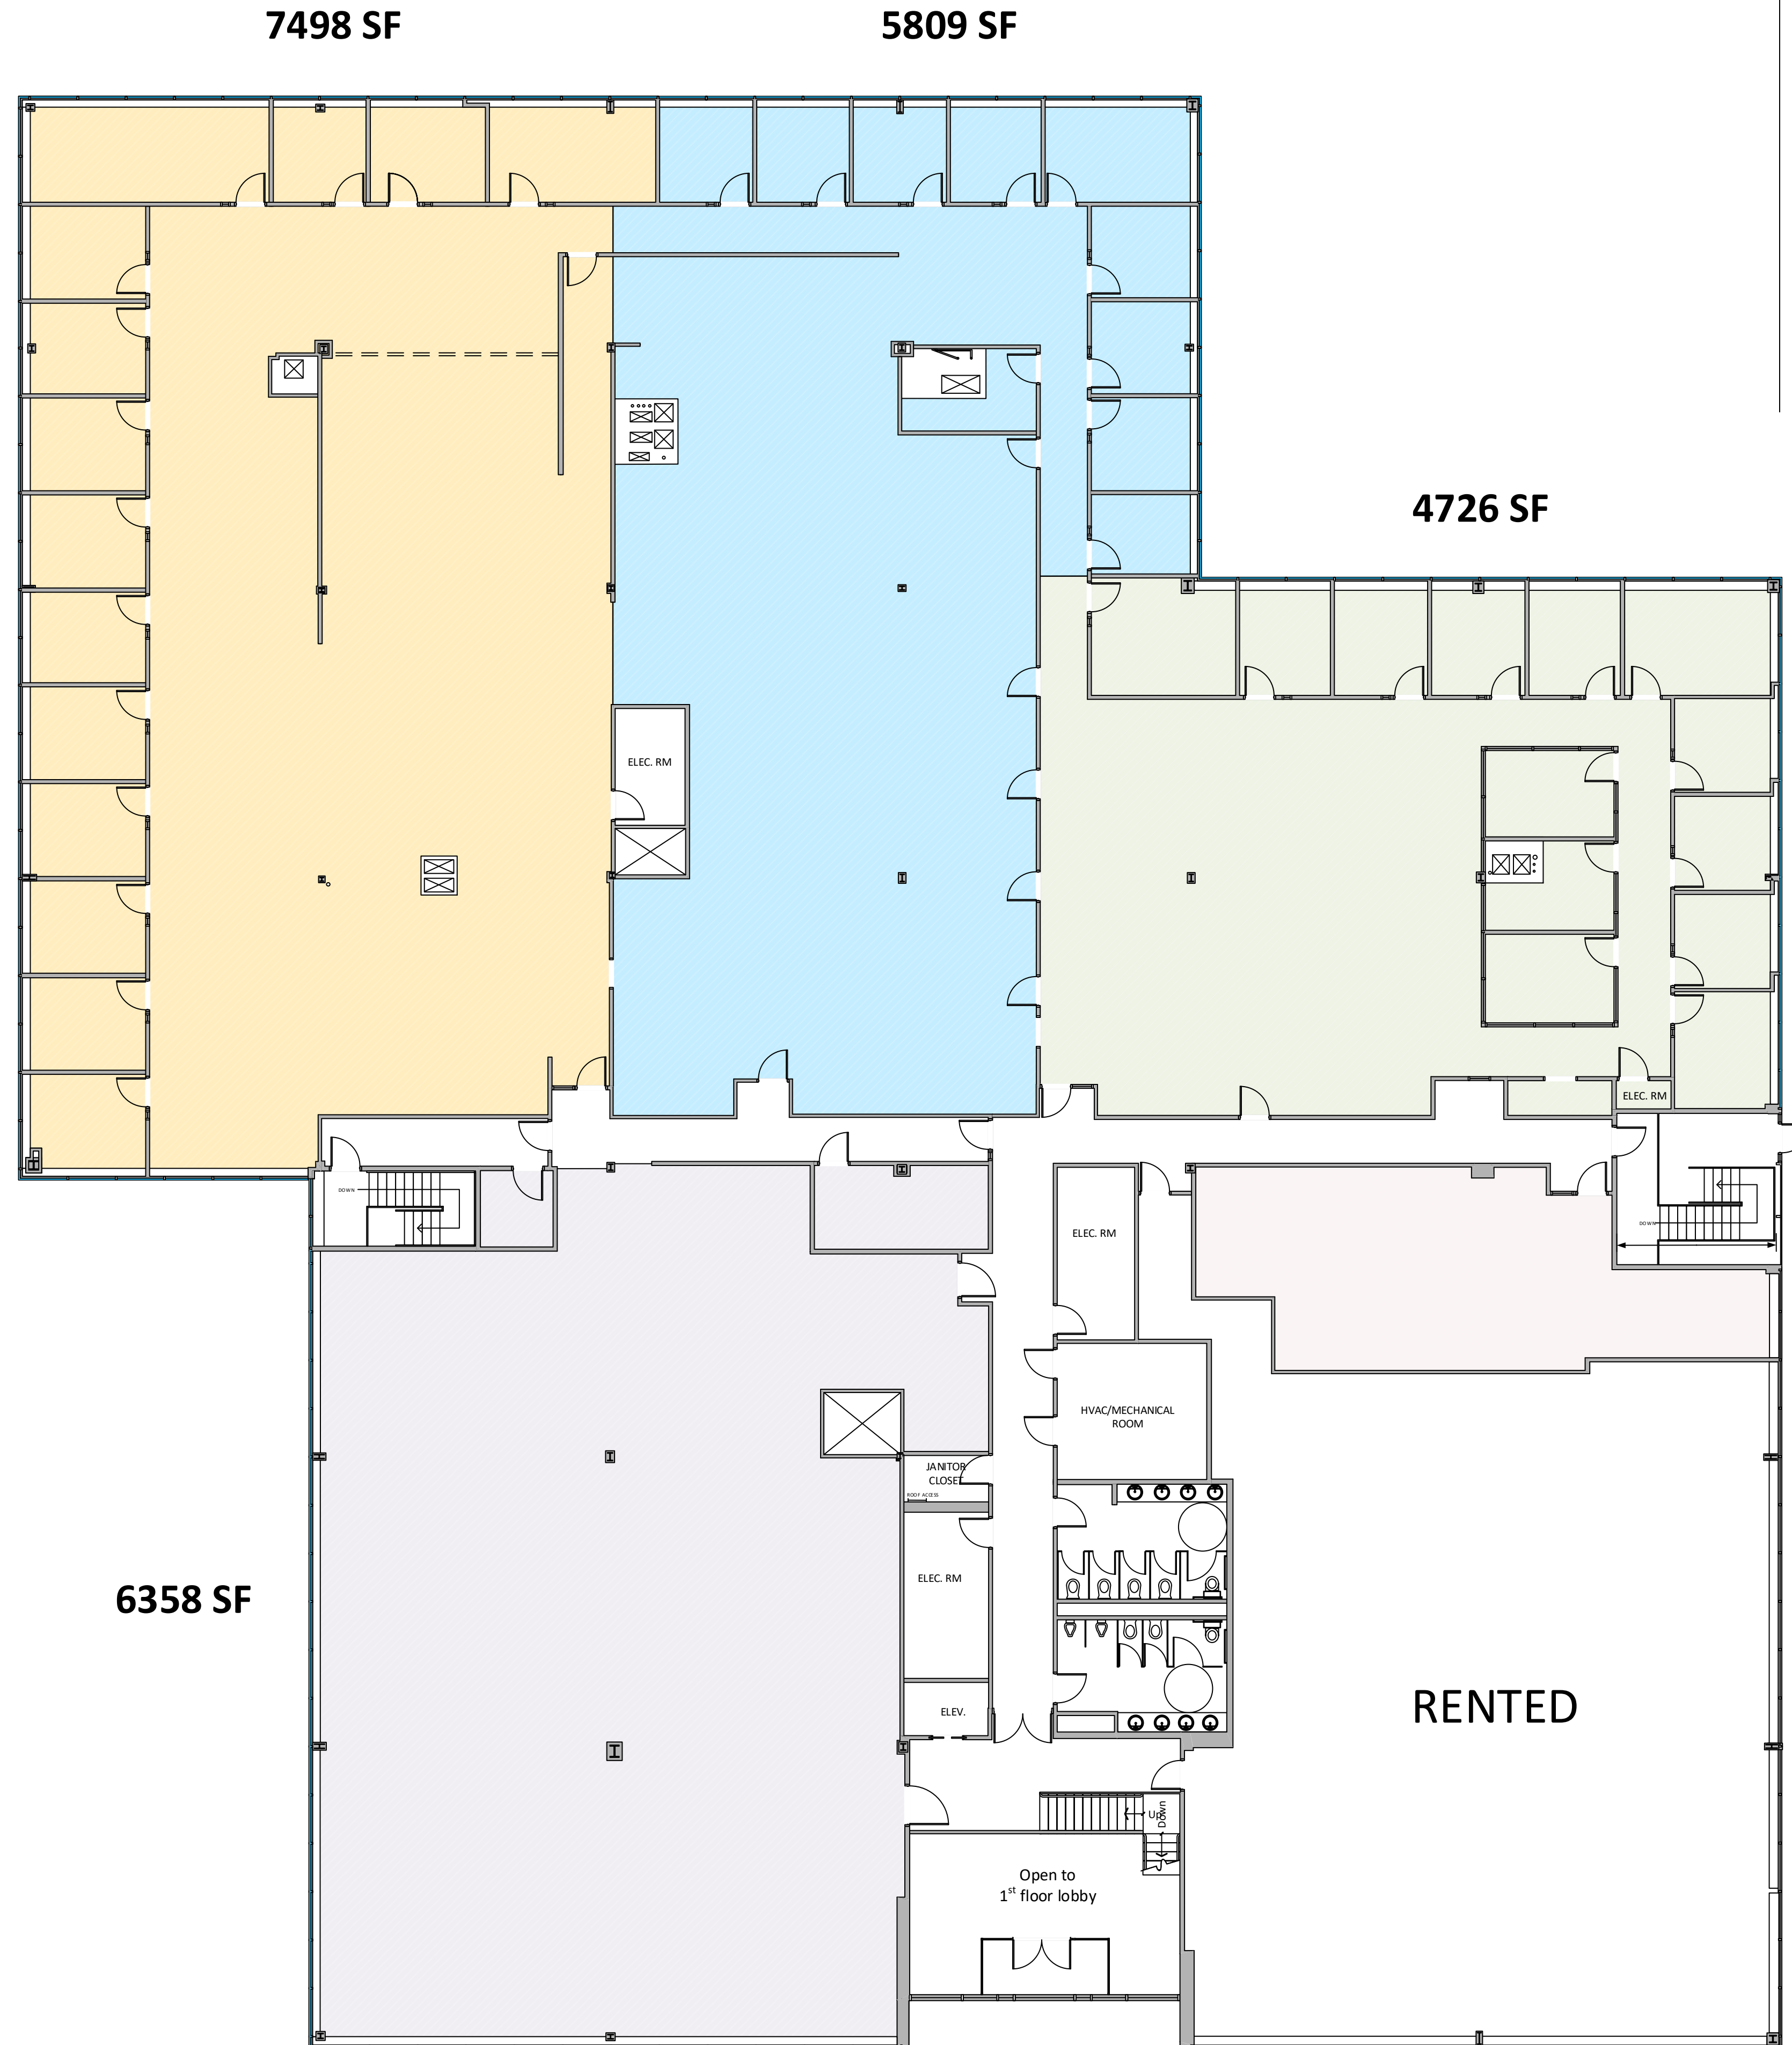

1135 SF

RENTED



501 Kings Highway East, Fairfield, CT 06825

Phone: 203-696-1000 Fax: 203-384-8000

[www.FischelProperties.com](http://www.FischelProperties.com)