




Spec Suites & Conference Center - As Built Conditions
3RD Floor – Suite A - 7,442 RSF | Suite B - 2,720 RSF | Suite C - 1,944 RSF

LEGEND

-  NEW CONSTRUCTION
-  EXISTING WALL TO REMAIN

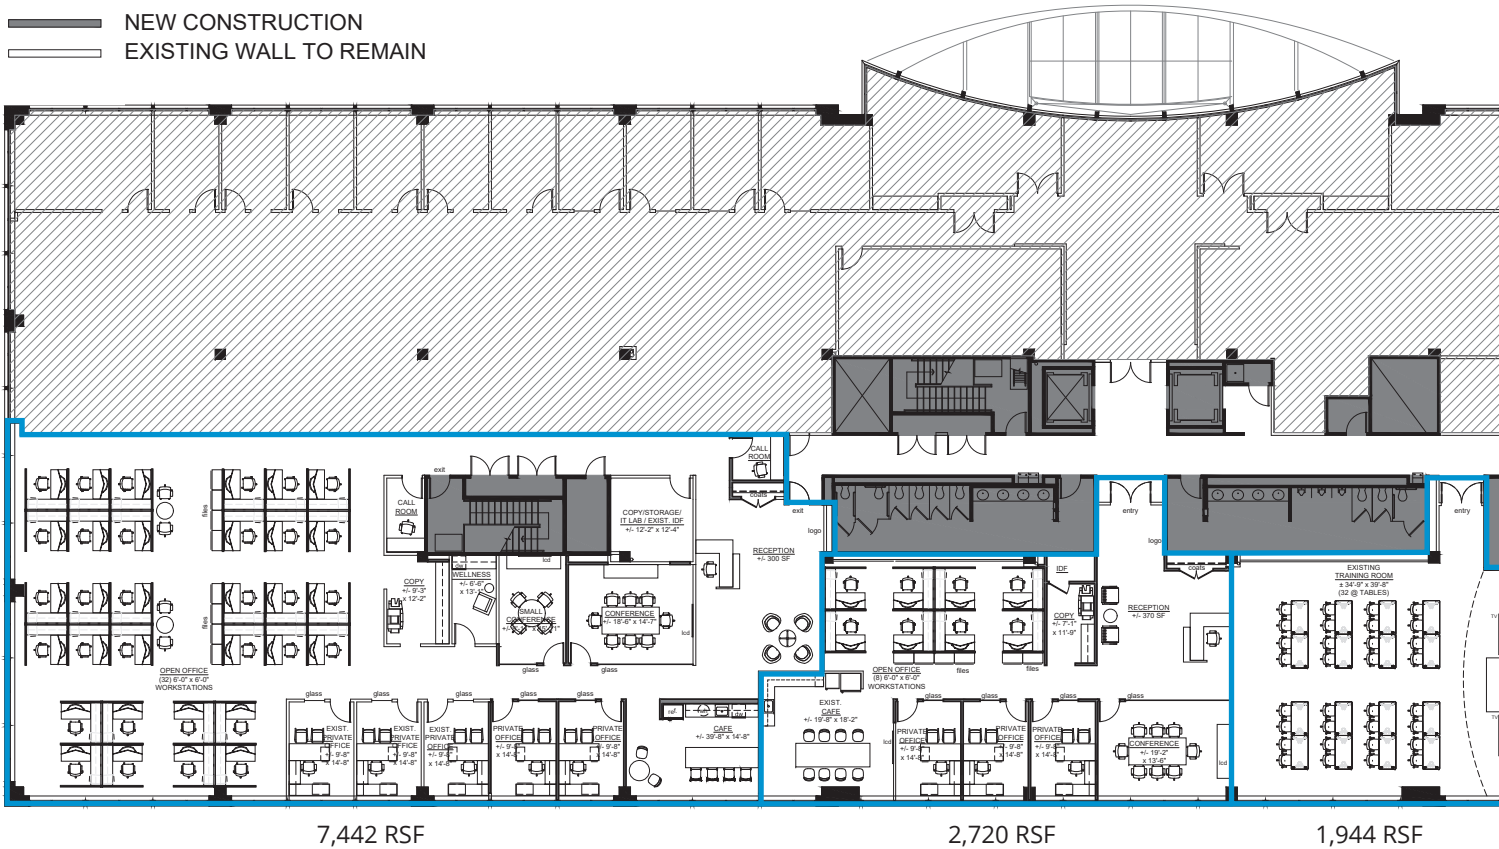

SUITE A
PLAN YIELD - 7,442

Total Staff Count:	38
Private Offices:	5
6'-0" x 6'-0" Workstations:	32
Reception:	1
Conference:	1
Small Conference:	1
Cafe:	1
Copy/Print:	1
IDF Clo.:	1
Coats:	1

SUITE B
PLAN YIELD -2,720 RSF

Total Staff Count:	12
Private Offices:	3
6'-0" x 6'-0" Workstations:	8
Reception:	1
Conference:	1
Small Conference:	0
Cafe:	1
Copy/Print:	1
IDF Clo.:	1
Coats:	1

For leasing inquiries:

JASON SIMON
+1 847 698 8531
jason.simon@colliers.com

JONATHON CONNOR
847 698 8246
jonathon.connor@colliers.com

Colliers International
6250 N. River Road
Suite 11-100
Rosemont, IL 60018
www.colliers.com/chicago

