


# SHEA MEDICAL PLAZA

7425 E SHEA BLVD, SCOTTSDALE, AZ 85260

FOR LEASE

SUITE 102 - 3,571 SF

AS BUILT

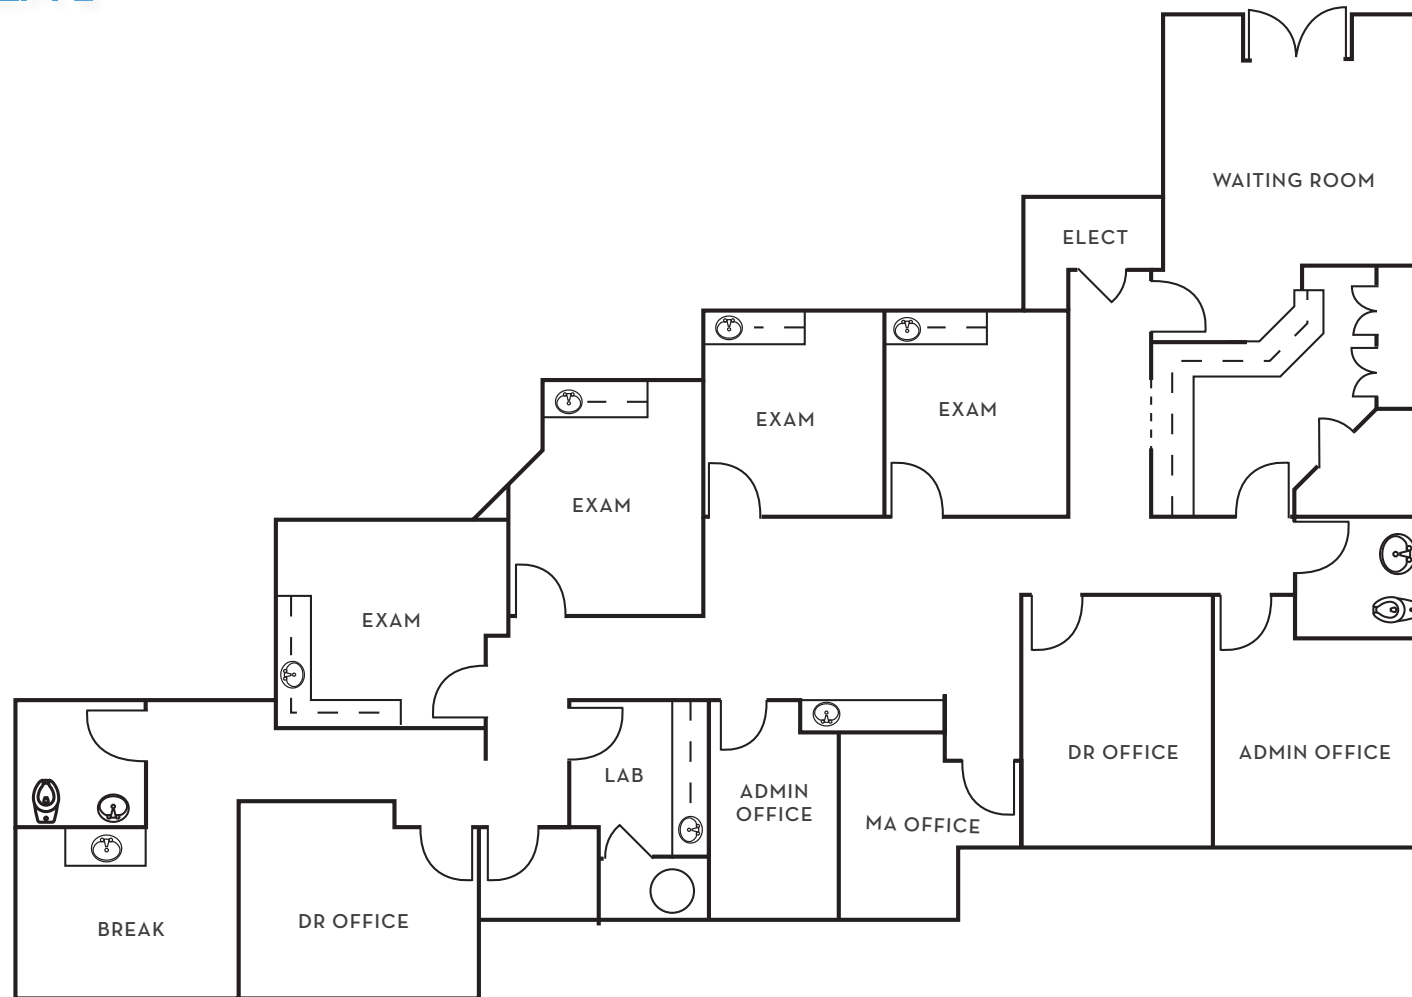

**RACHAEL THOMPSON**  
602.513.5122  
rachael.thompson@kidder.com

**PERRY GABUZZI**  
602.513.5116  
perry.gabuzzi@kidder.com

[kidder.com](http://kidder.com)

