



SUITE 105 & 106
AS BUILT - 1 OF 1
200 PROVIDENCE - LEVEL ONE
4,660 RSF
SCALE: 3/32" = 1'-0"
DATE: OCTOBER 17, 2022

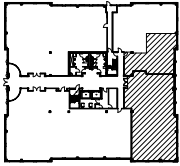

KEY PLAN

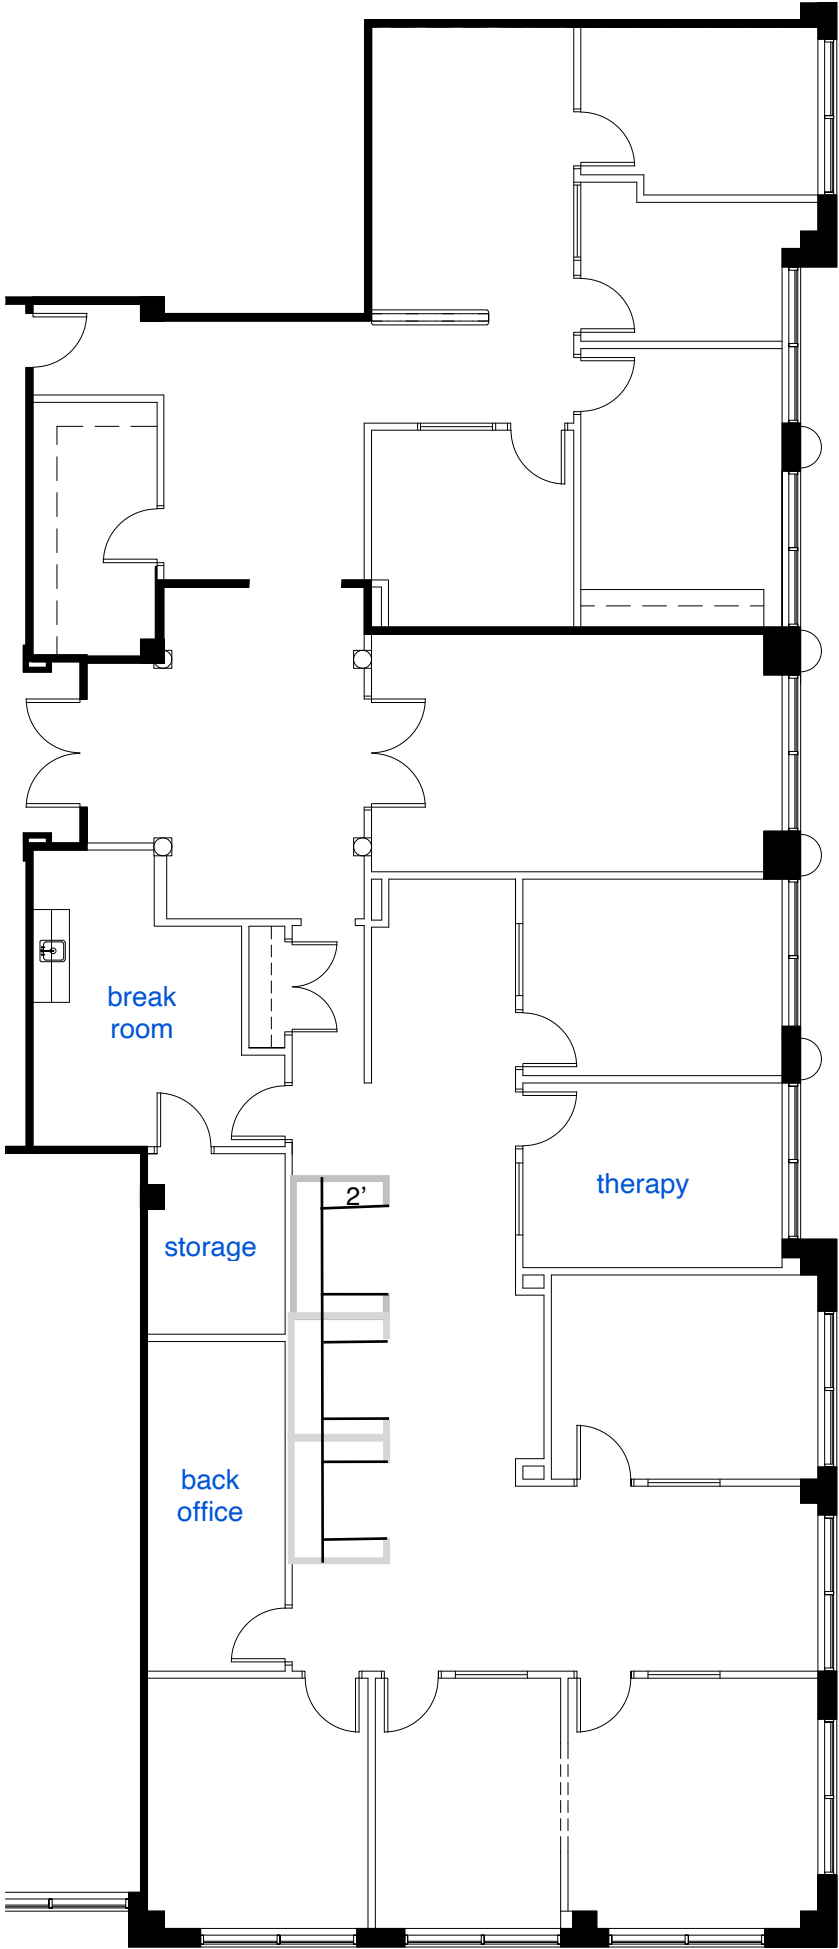

SMITH
HARRIS
DESIGN
associates