
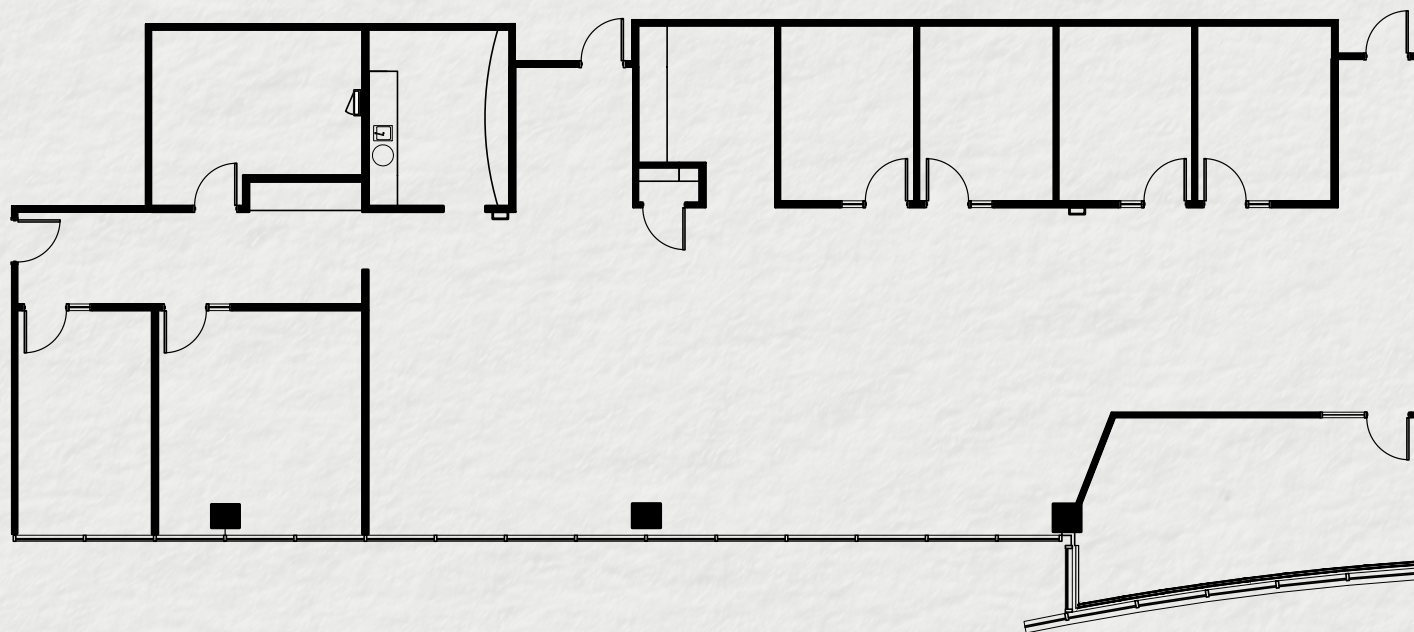


9400
W. HIGGINS

4,248 SF

SUITE 215

AS-BUILT CONDITIONS

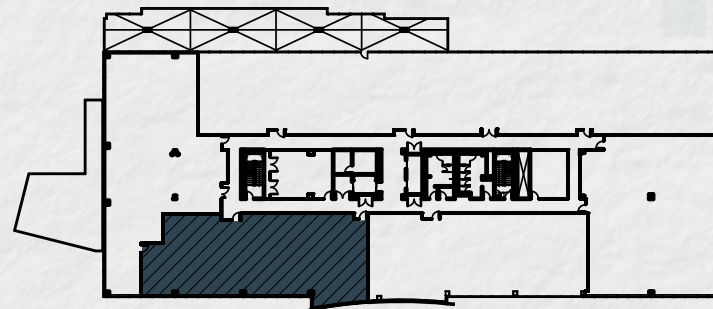

←
NORTH

ROSEMONT, ILLINOIS, 60018

NINETY-FOUR HUNDRED HIGGINS ROAD

JOSH CRANE
SENIOR DIRECTOR
+1 312 424 8151
JOSH.CRANE@CUSHWAKE.COM

AAOS
AMERICAN ACADEMY OF
ORTHOPAEDIC SURGEONS

 **CUSHMAN &
WAKEFIELD**