


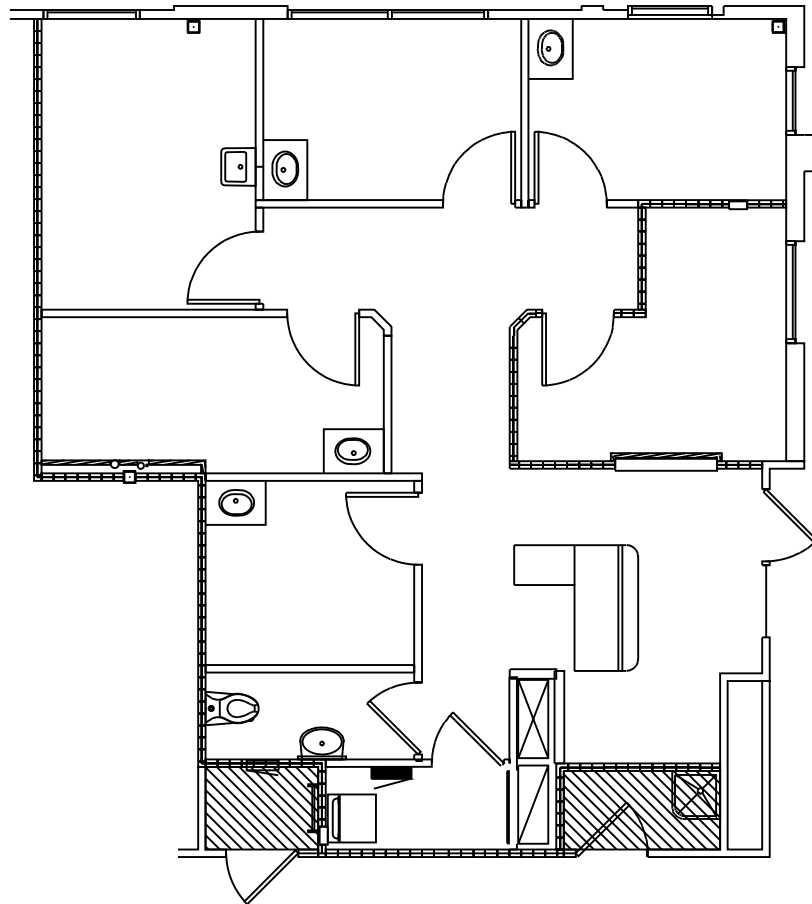

1

Reduced As-Built

Suite 220

1,132 USF (Approx.)

Scale: 1/8" = 1'-0"



North

Suite 220

12880 Colorado Boulevard

Reduced As-Built

Sheet 1 of 1

As-Built Plan
Issued: 30 July 2026
Drawn by: MCP / AT / AT
TPS Project #: 200584

12880 Colorado Boulevard
Level Two; Suite 220
12880 Colorado Boulevard
Thornton, CO 80241

TPS
1660 Lincoln St, Ste. 100
Denver, Colorado 80264
(303) 861-4800
www.TPS.design