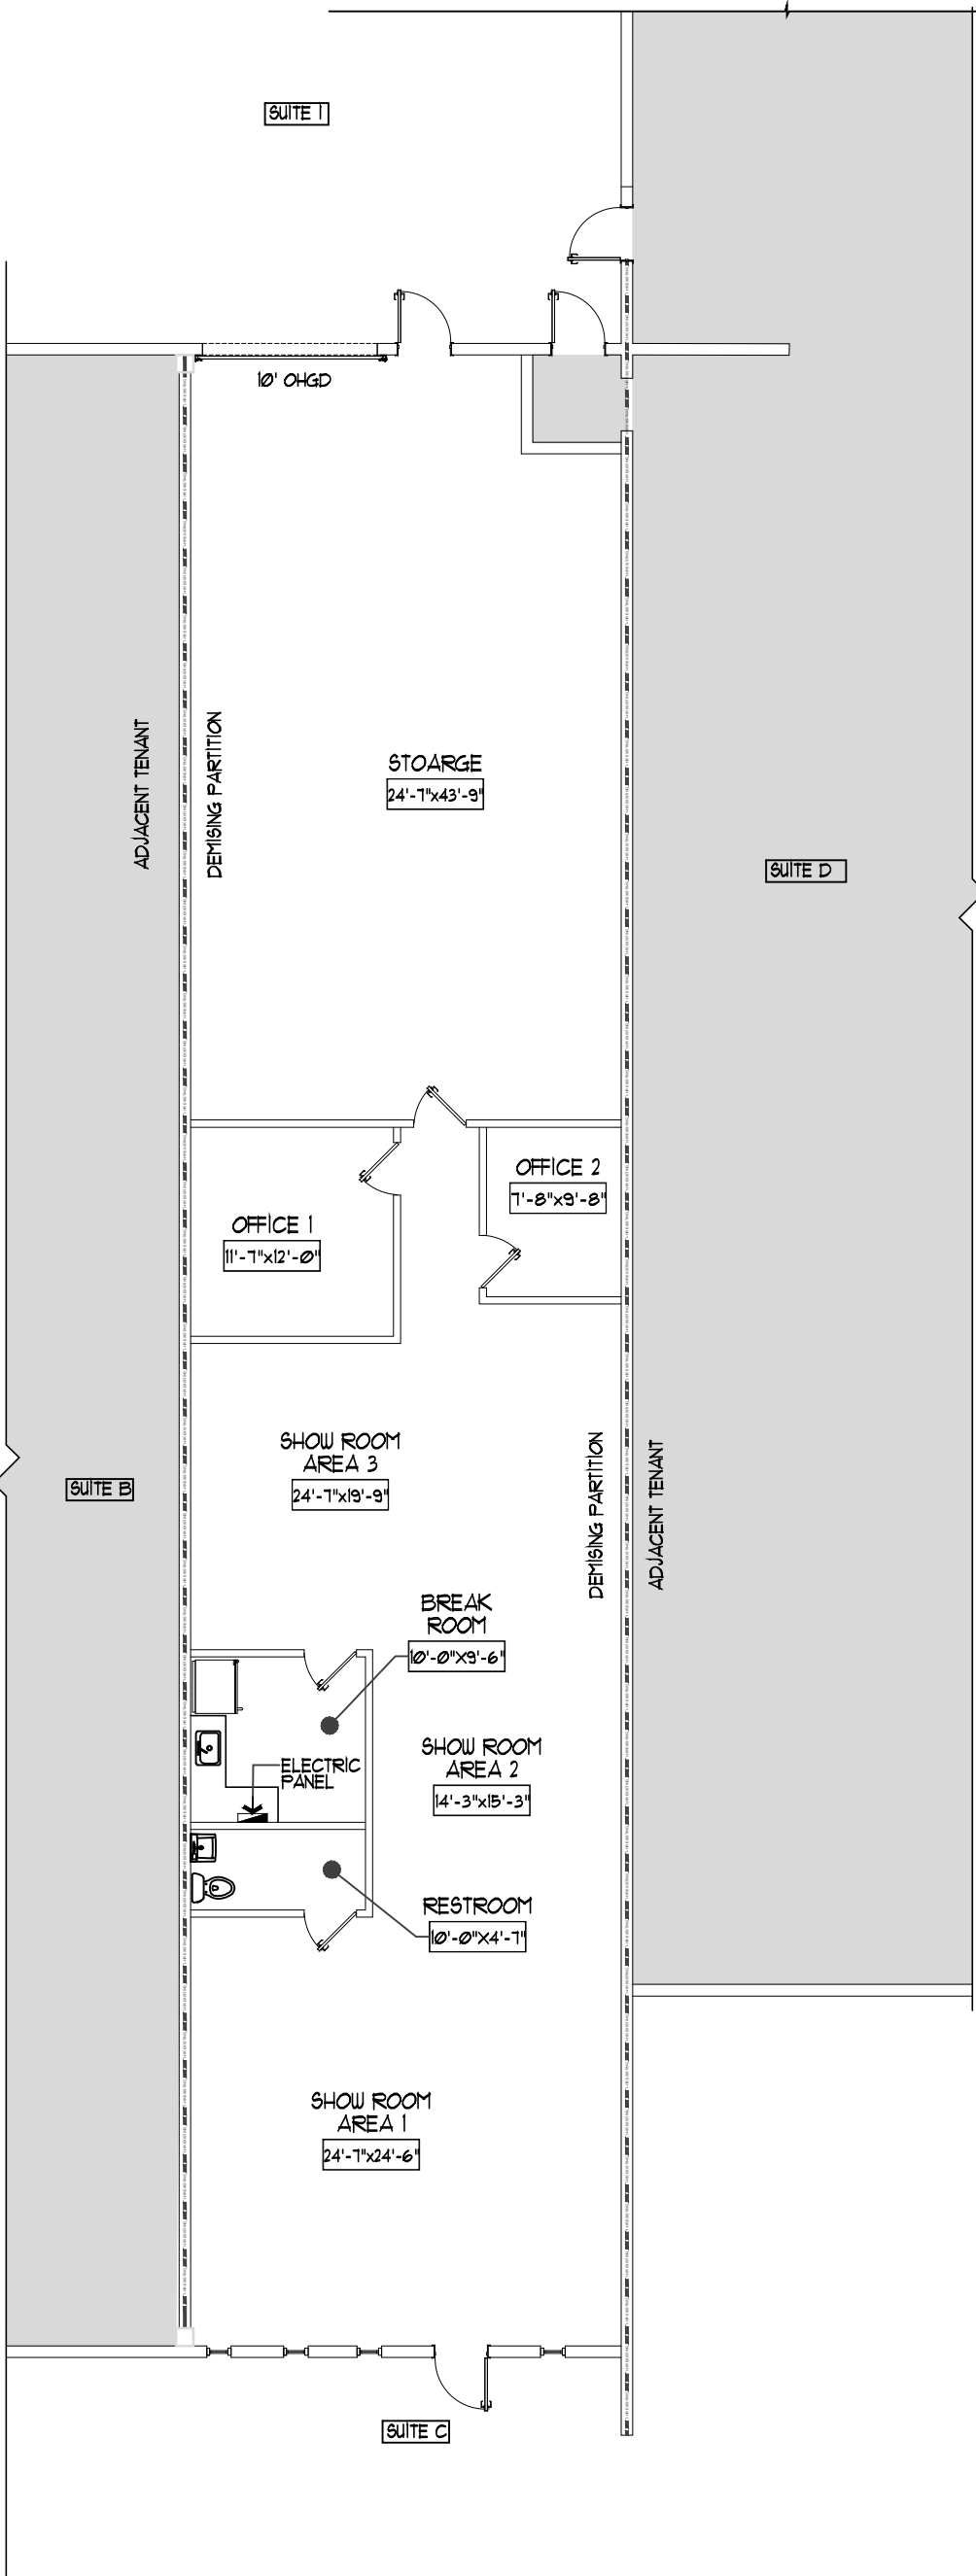


STEVEN E. MYOTT
ARCHITECT

639 e. ocean ave, suite 403
boynton beach, florida
www.semarchitecture.com
p: 561.734.7034

-MINDFUL CAPITAL GROUP-
AS-BUILT PLAN

101 CONGRESS AVE.,SUITE C,
DELRAY BEACH, FLORIDA 33445

ALL DRAWINGS AND WRITTEN MATERIAL APPEARING HEREIN
CONSTITUTE ORIGINAL & UNPUBLISHED WORK OF THE
ARCHITECT AND MAY NOT BE USED, DUPLICATED OR
DISCLOSED IN ANY FORM WITHOUT THE EXPRESSED WRITTEN
CONSENT OF THE ARCHITECT

PROJECT NO: 20.142
DRAWN BY: LM
CHECKED BY: SM

NO: 1
DATE: 11.09.2020
ISSUED FOR: PRELIMINARY REVIEW

SCALE: 3/32" = 1'-0"

SUITE C

A-1