


2ND FLOOR
PHONE/DATA
ROOM

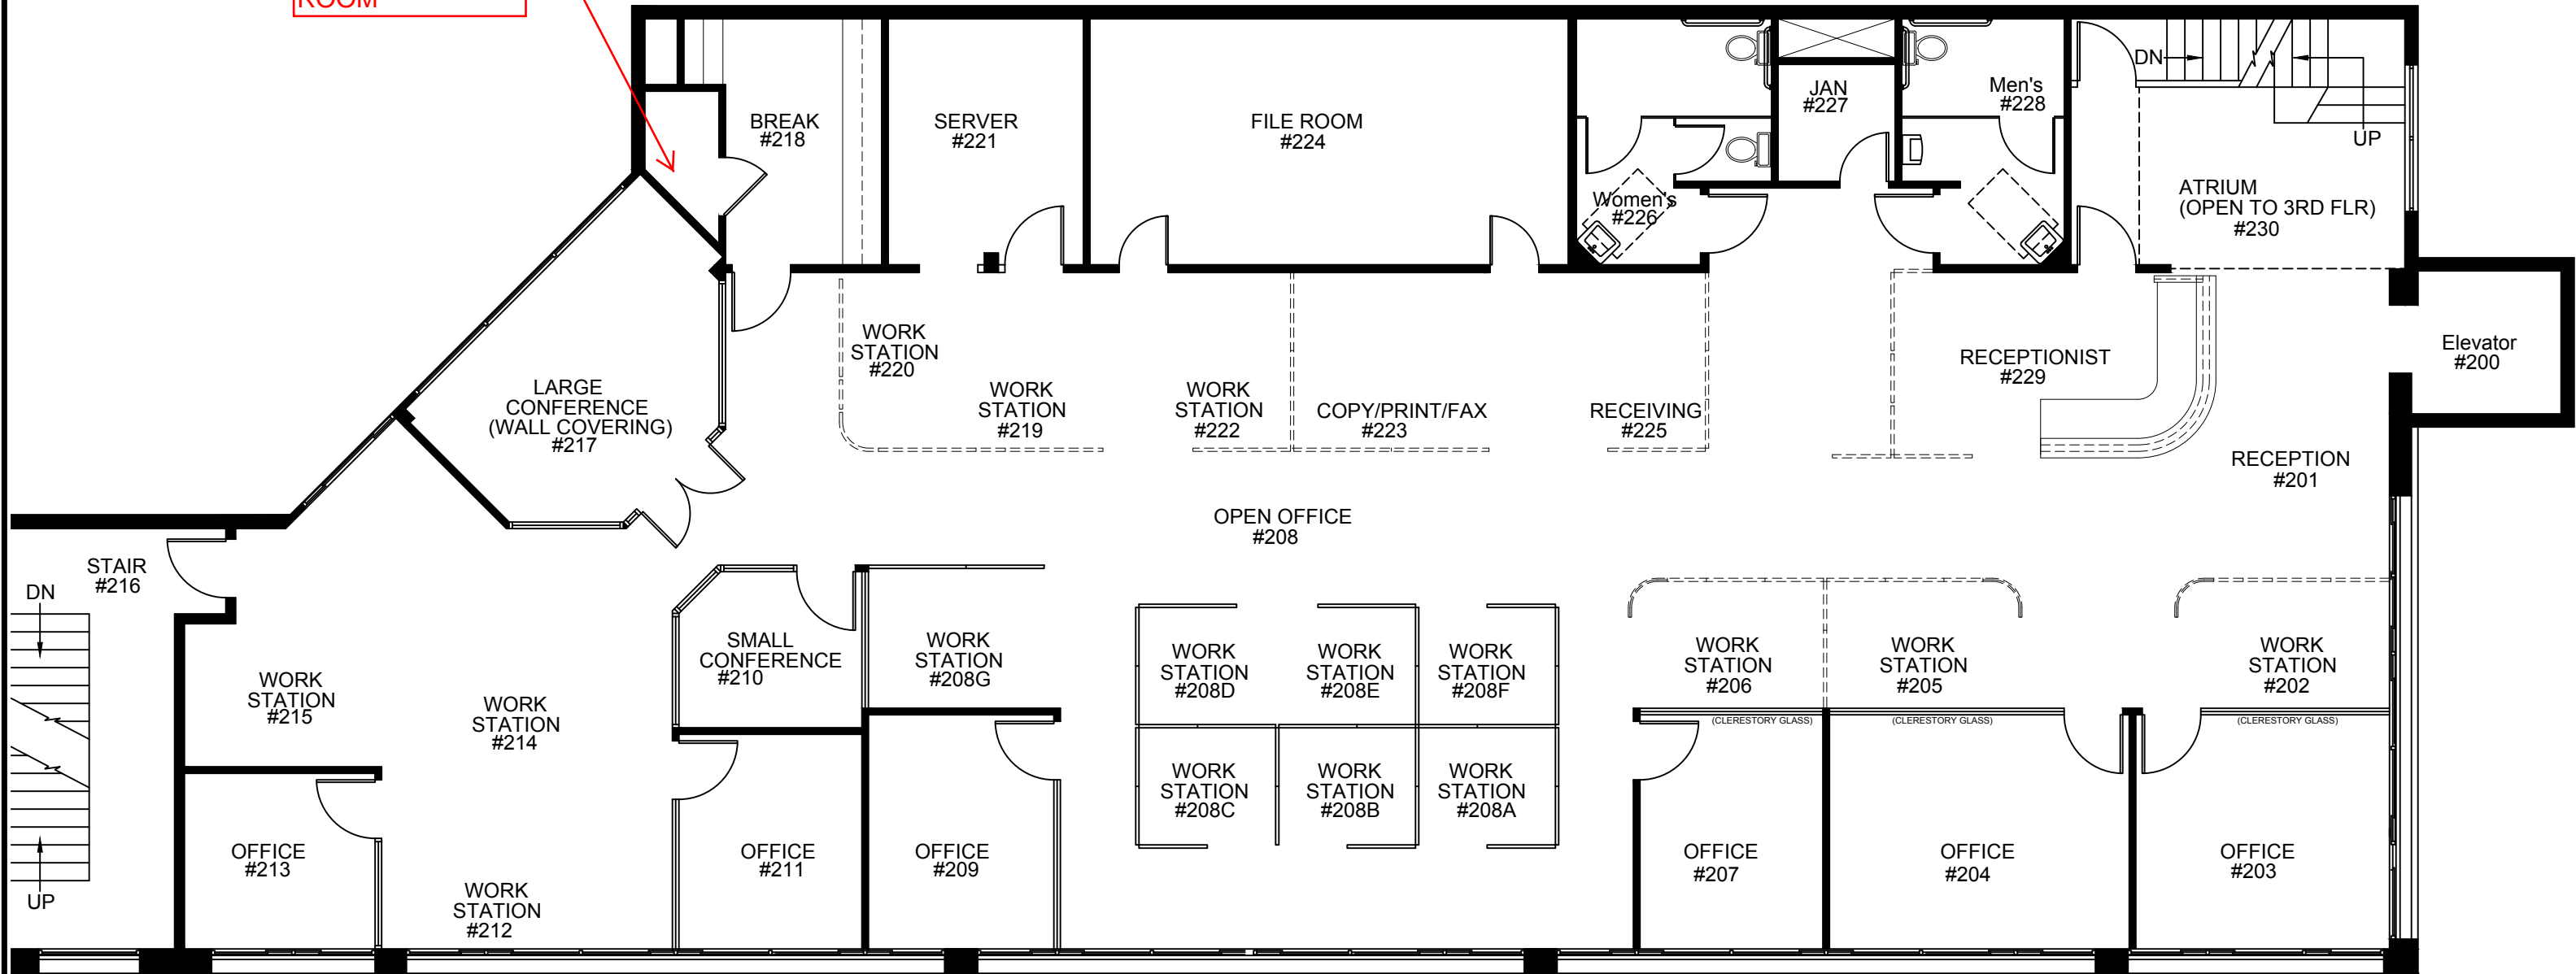


**NATION'S FOODSERVICE
#99 OFFICE - SECOND FLOOR PLAN**
 SCALE: 1/8" = 1'-0"

Drawn By: MLK
 Date: 7-14-17
 Plot Date: 7-14-17
 Scale: 1/8" = 1'-0"

AS-BUILT FLOOR PLAN
NATION'S FOODSERVICE
 El Cerrito, California
 File:99 AB L2 2017



NATION'S FOODSERVICE, INC.
 11090 SAN PABLO AVE., SUITE 200
 EL CERRITO, CA 94530-2365

SHEET NO:
AB-99