
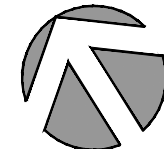
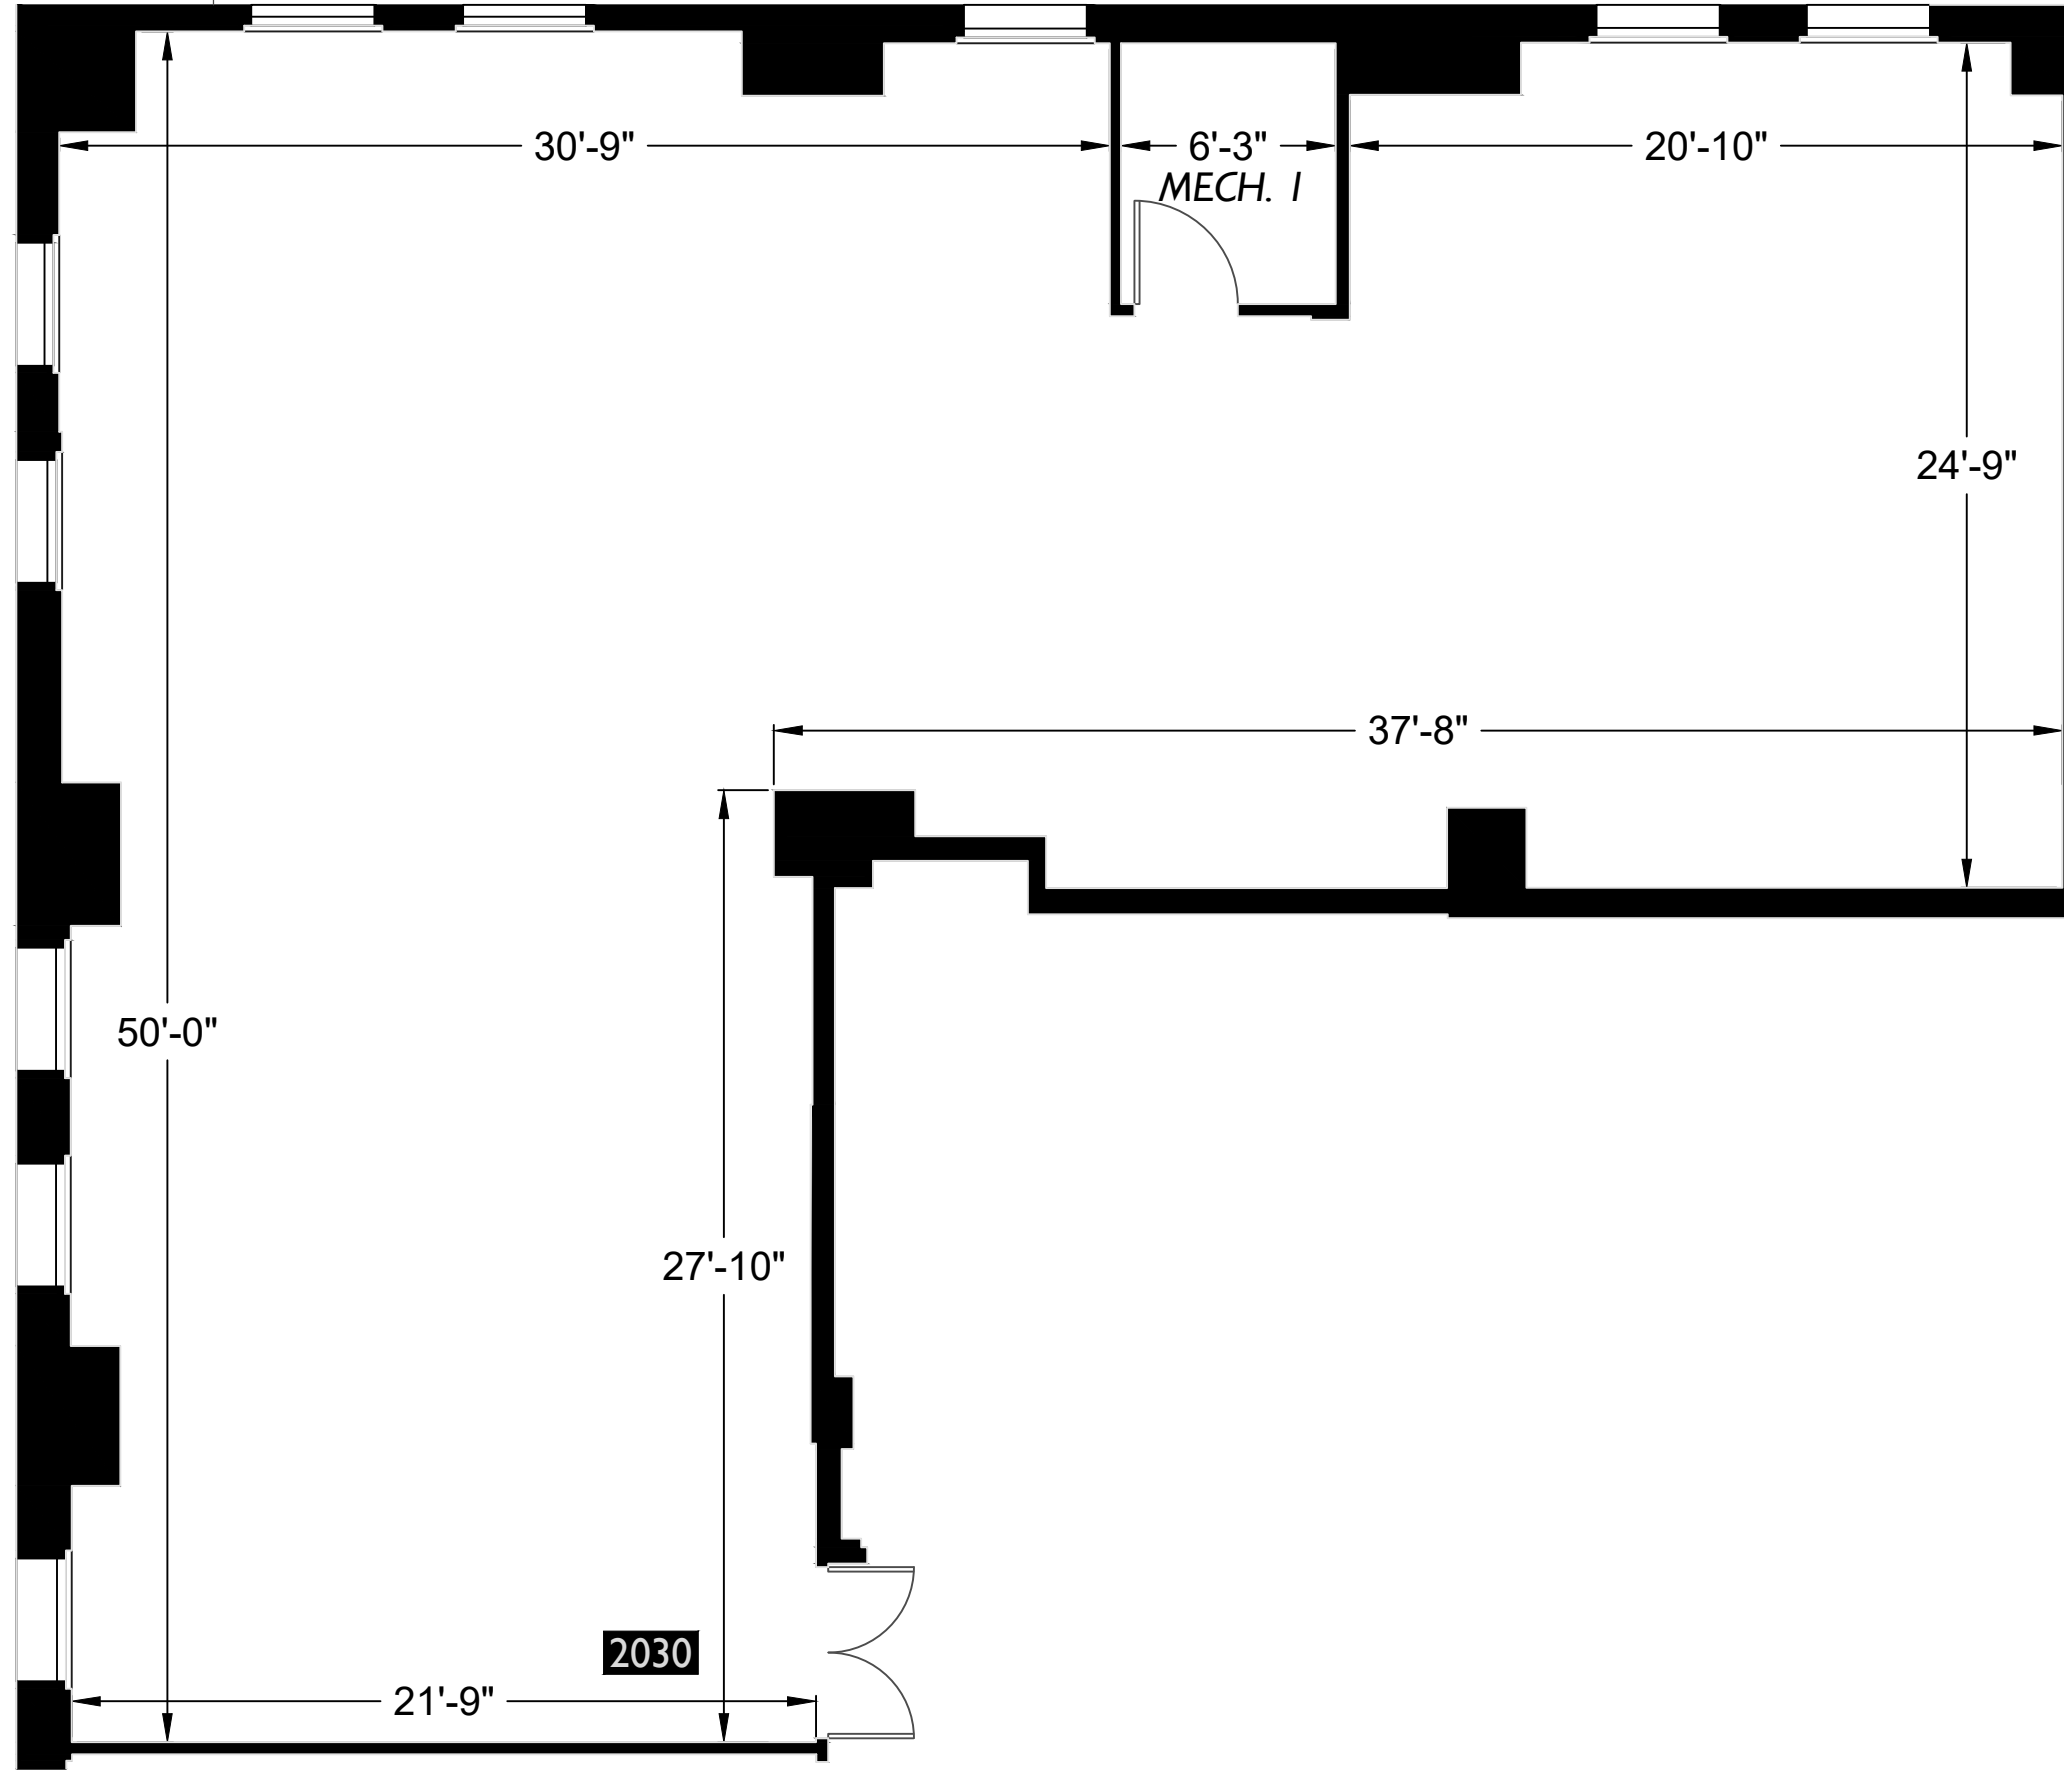



Barclay Street

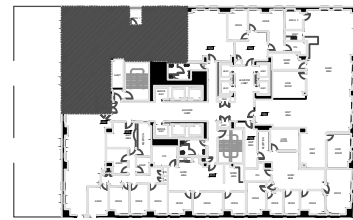

Broadway

Braun Management, Inc 160 Broadway, First Floor New York, NY 10038	Office Building 225 Broadway New York, NY 10007	Floor Plan SUITE 2030	Scale	2DFLOORPLANS.COM 206-328-7410 2-D AS-BUILT FLOOR PLANS Measured: May 2017
Client	Subject	Floor	Scale	Project: C25-557

2DFLOORPLANS.COM
 206-328-7410
2-D
 AS-BUILT
 FLOOR PLANS
 Measured: May 2017

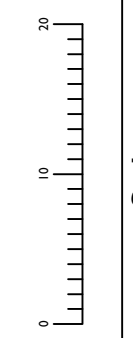

Floor Plan
SUITE 2030

Office Building
 225 Broadway
 New York, NY 10007

Braun Management, Inc
 160 Broadway, First Floor
 New York, NY 10038

Project: C25-557