




**Blumentals
Architecture**

1600 Marshall Street NE, Suite 1
Minneapolis, MN 55413
612/331-2222
info@blumentals.com

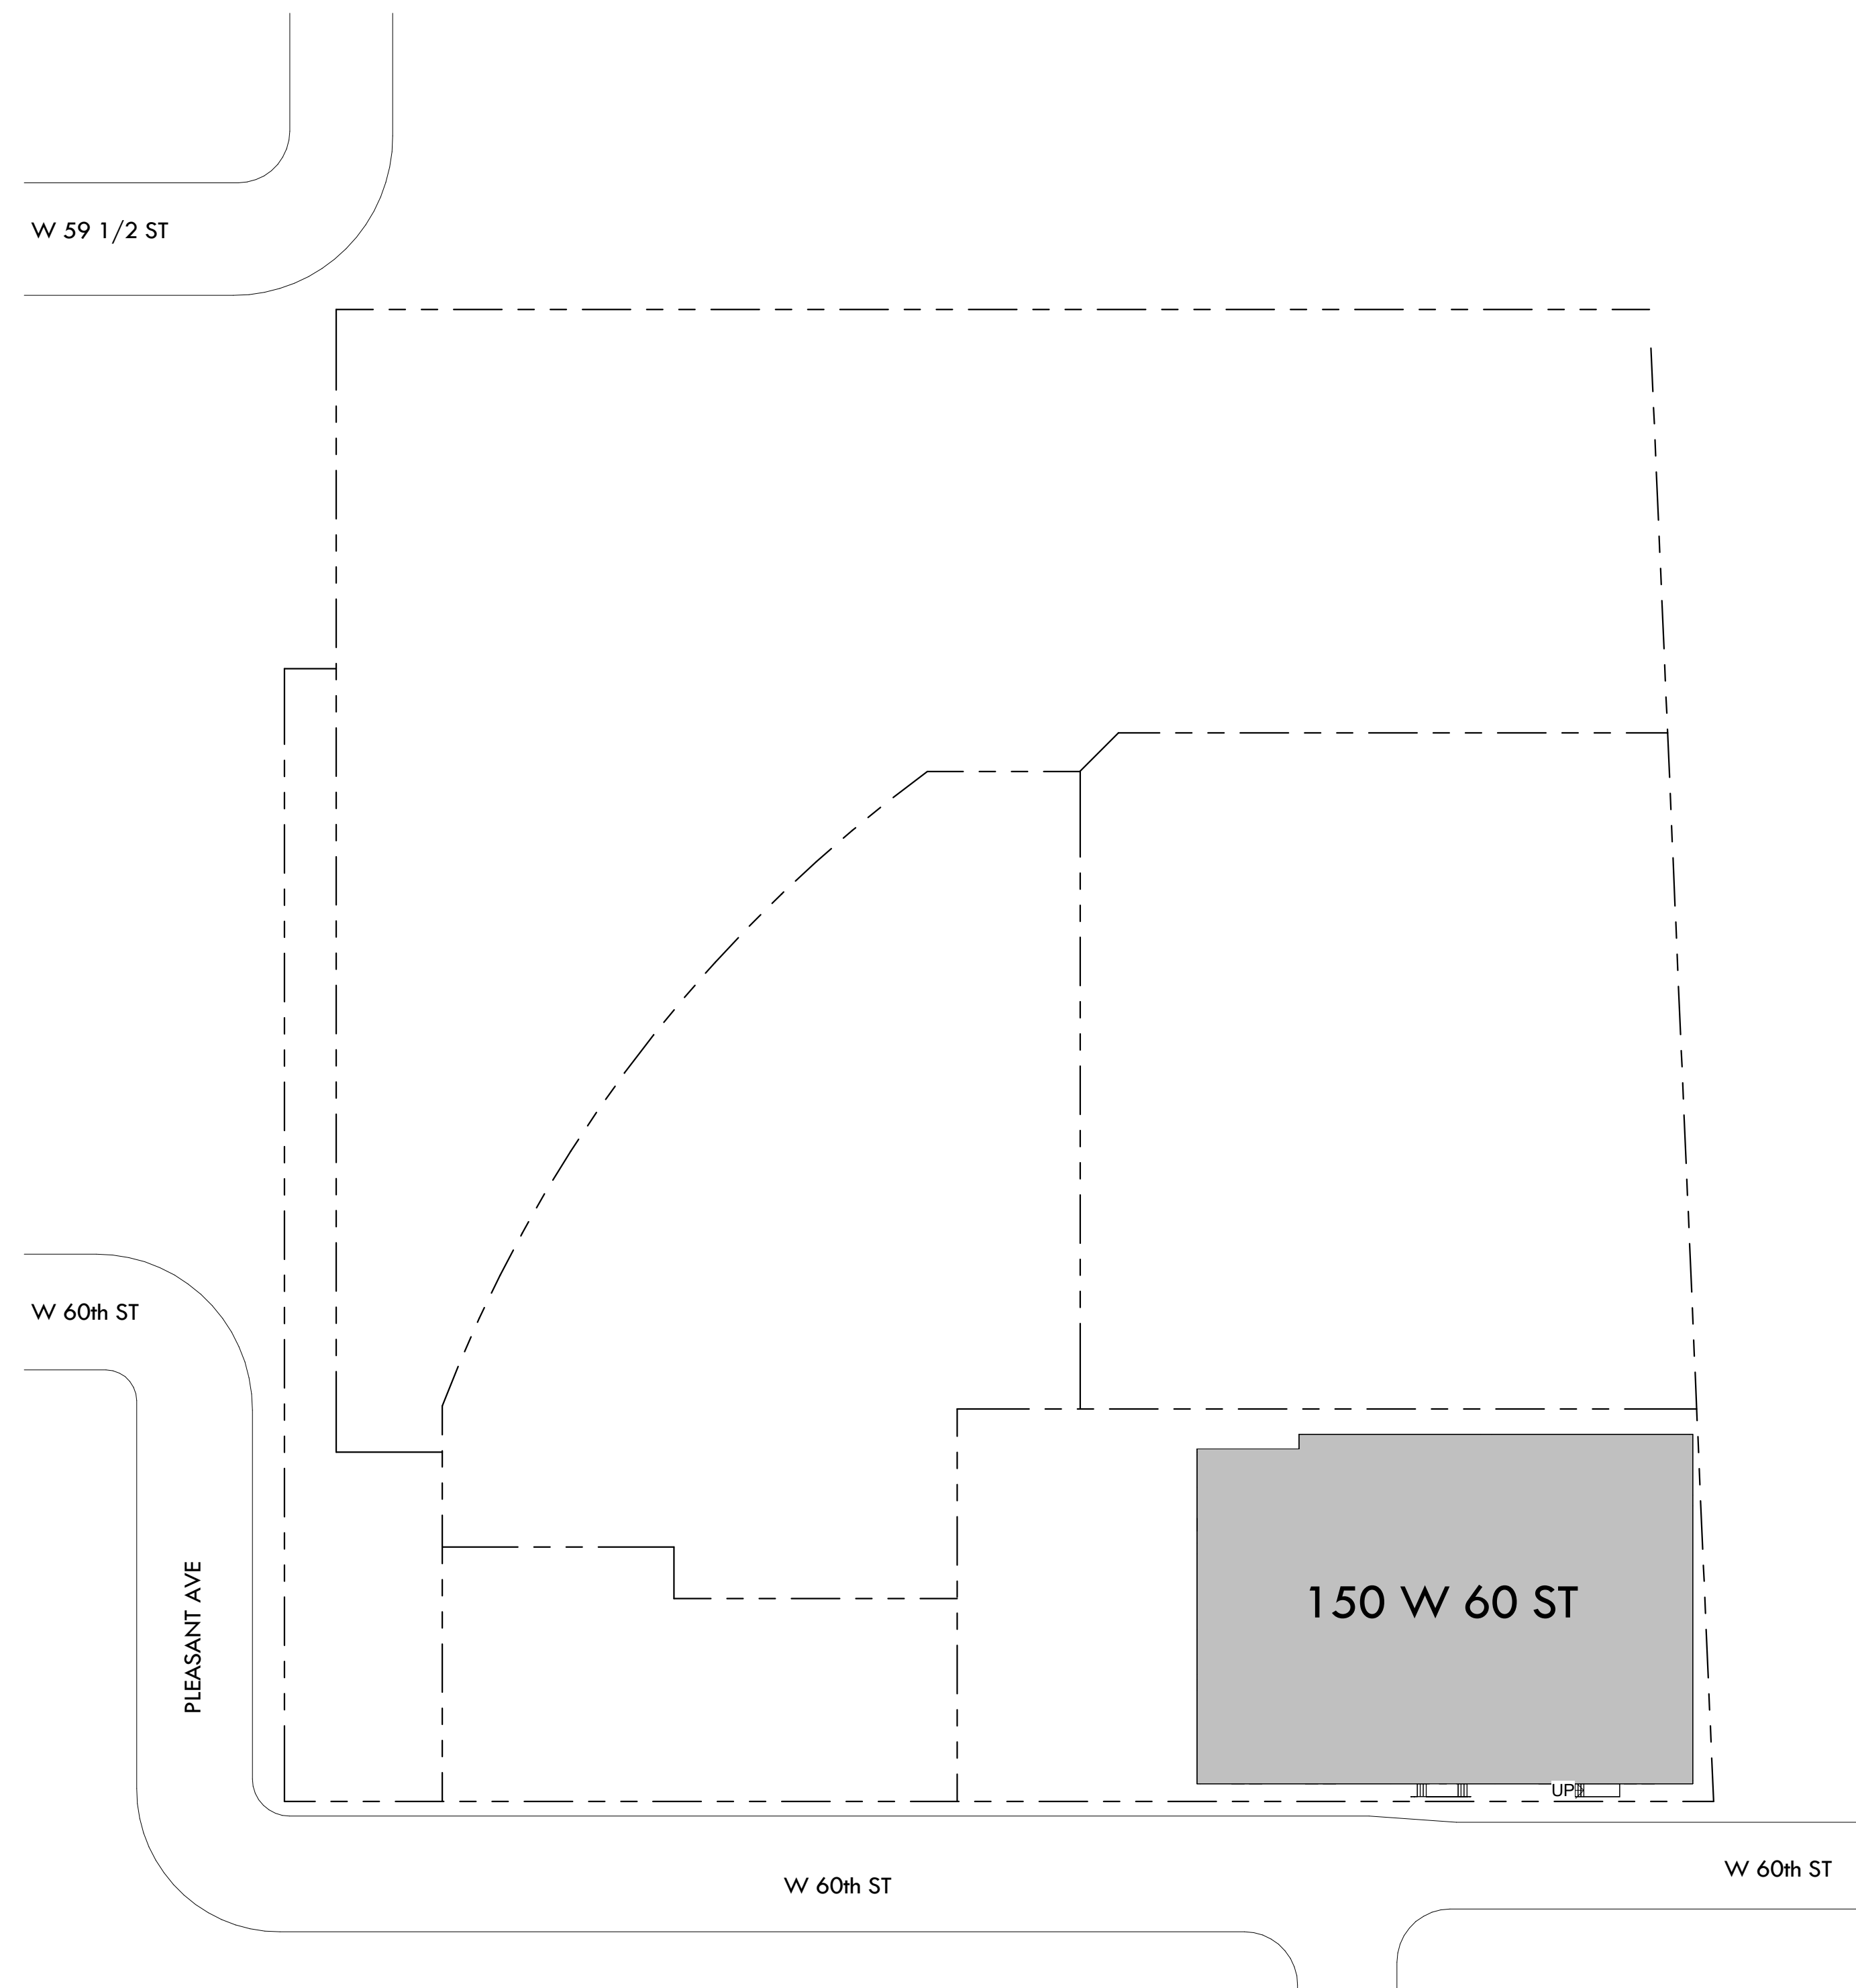

1 SITE PLAN-IMAGE
1" = 40'-0"

2 SITE PLAN
1" = 40'-0"

**PRELIMINARY
DRAWINGS**
• NOT FOR CONSTRUCTION

ISSUES / REVISIONS

ISSUES / REVISIONS

EXISTING CONDITIONS

VERIFY ALL EXISTING CONSTRUCTION DIMENSIONS, ELEVATIONS AND CONDITIONS BEFORE STARTING ANY CONSTRUCTION. REVIEW ANY DISCREPANCIES WITH THE ARCHITECT. ADJUST NEW CONSTRUCTION AS REQUIRED.

150 W 60th St - AS-BUILTS

150 W 60th St Minneapolis, MN

B/A Project Number: **624-17**

SITE PLAN


A101



**Blumentals
Architecture**

1600 Marshall Street NE, Suite 1
Minneapolis, MN 55413
612/331-2222
info@blumentals.com

**PRELIMINARY
DRAWINGS**
• NOT FOR CONSTRUCTION

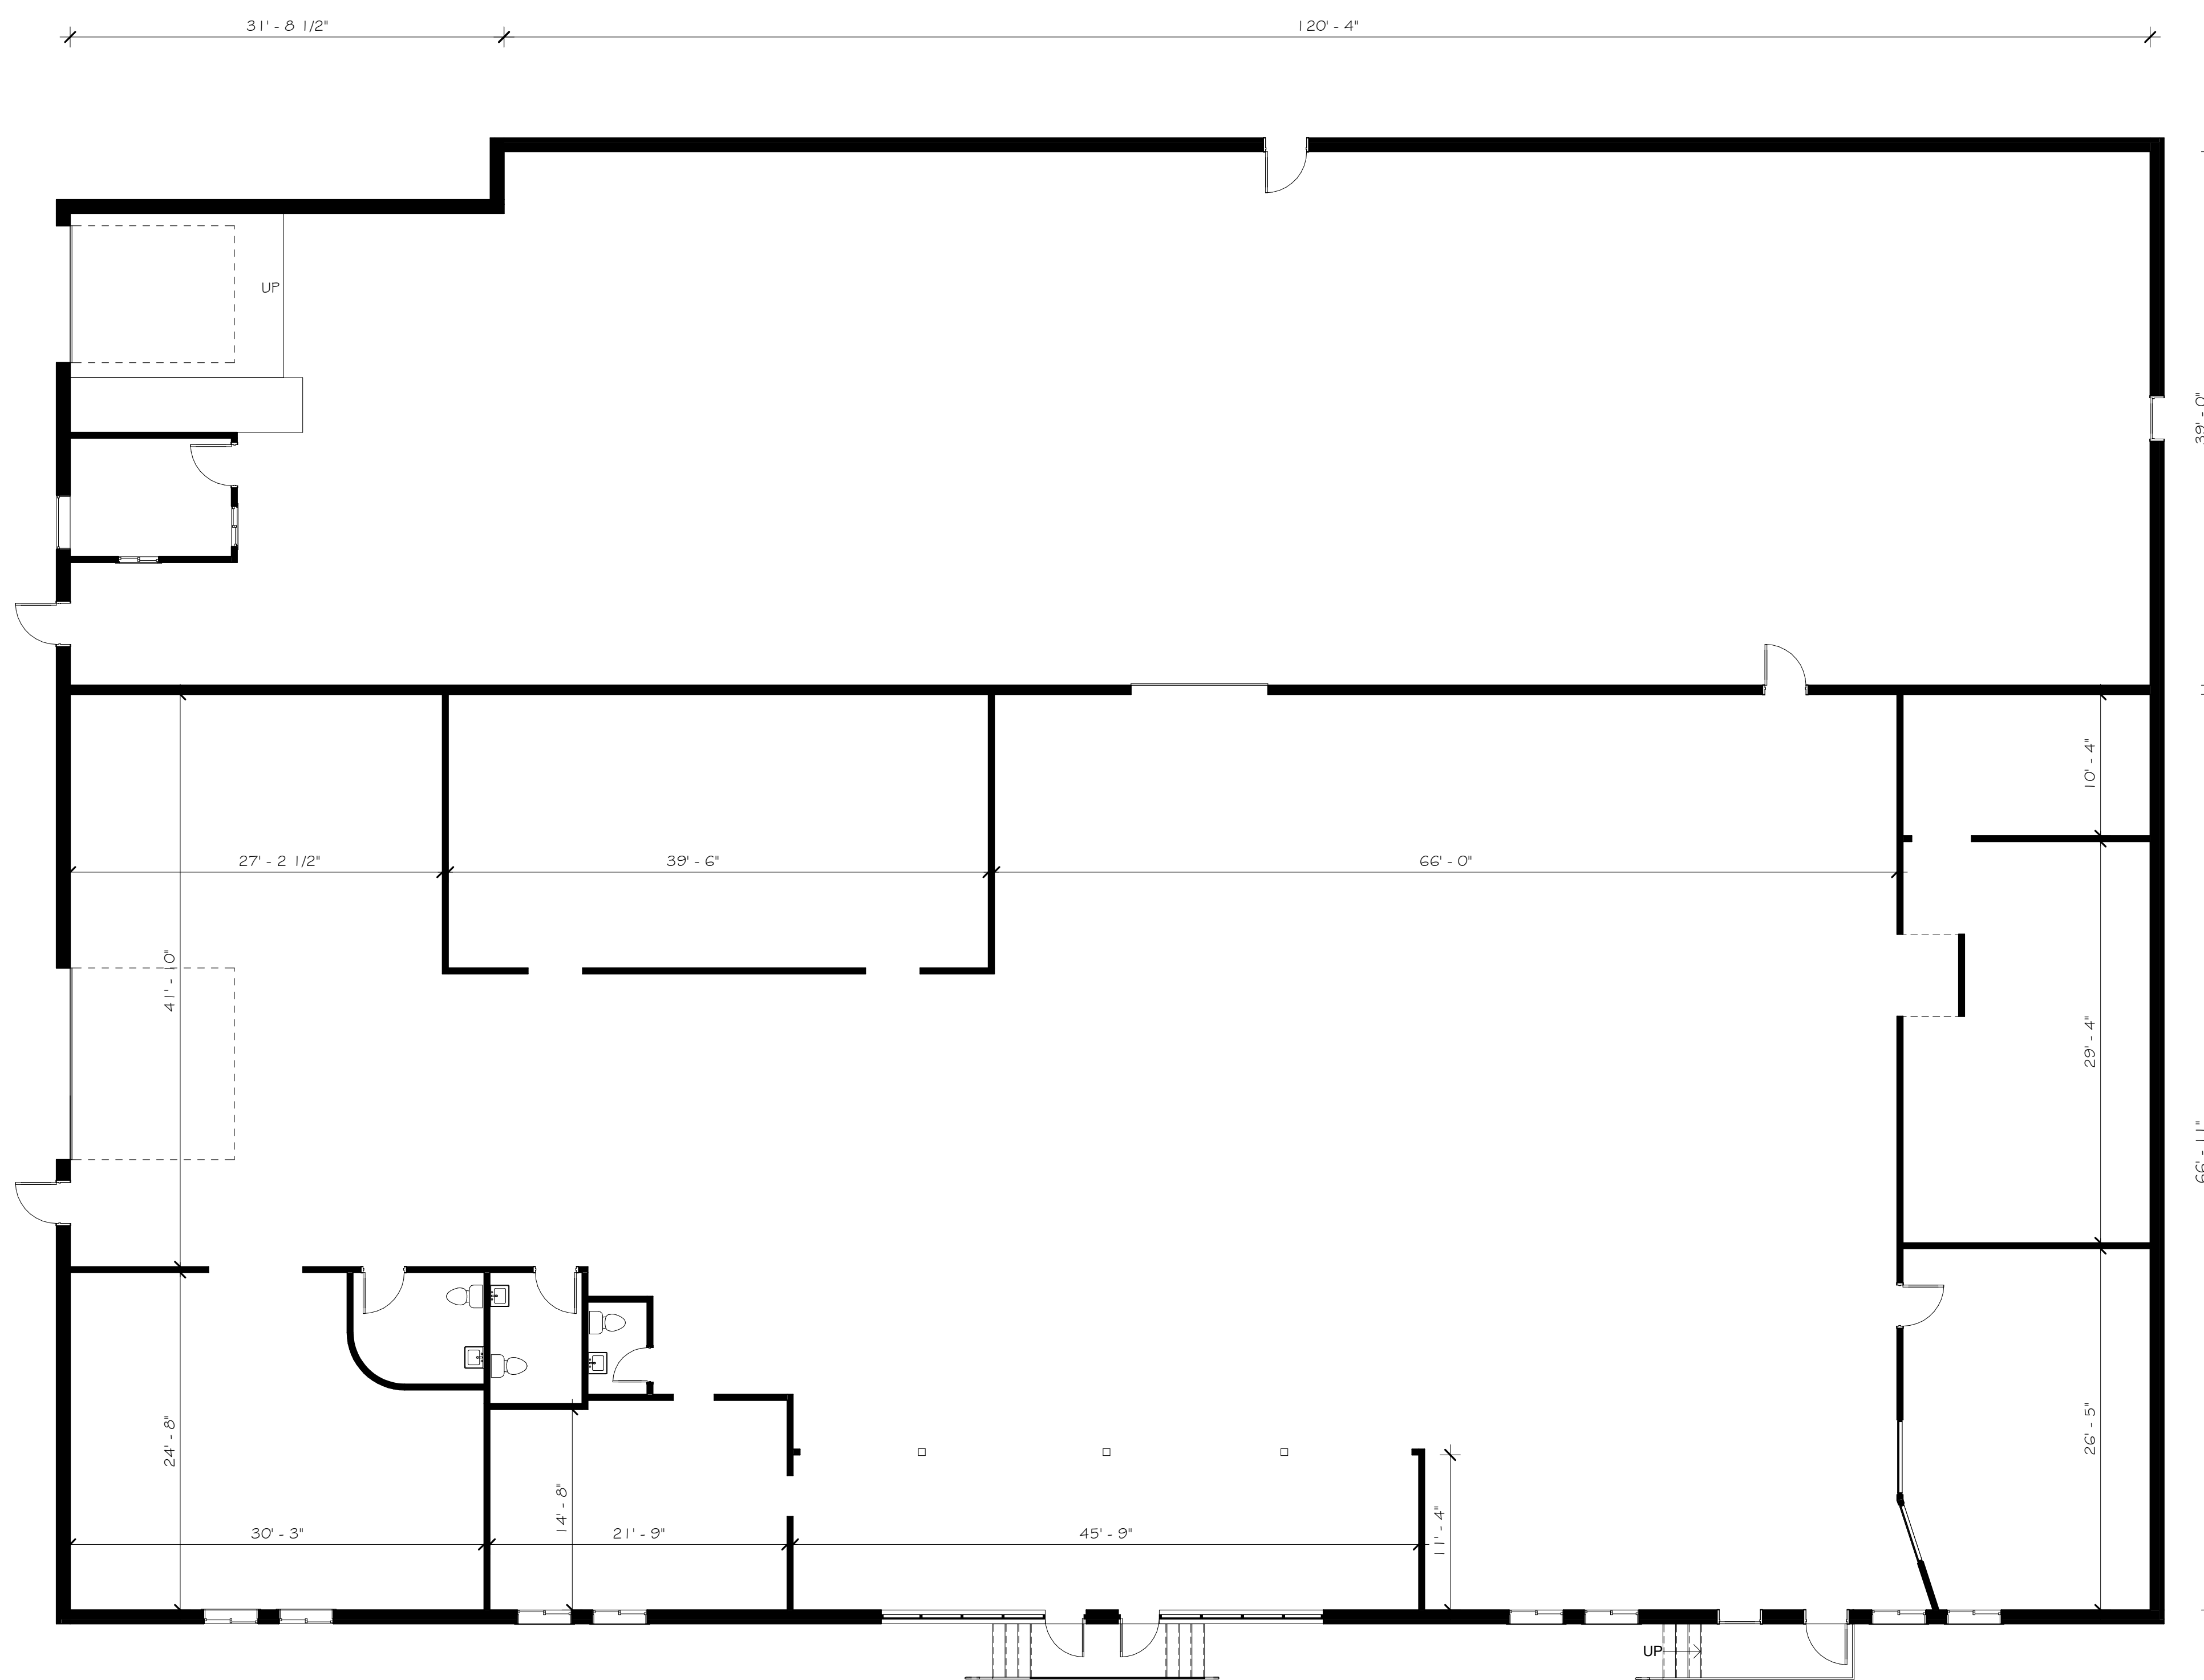

1 FIRST FLOOR
1/8" = 1'-0"

ISSUES / REVISIONS

EXISTING CONDITIONS

VERIFY ALL EXISTING CONSTRUCTION DIMENSIONS, ELEVATIONS AND CONDITIONS BEFORE STARTING ANY CONSTRUCTION. REVIEW ANY DISCREPANCIES WITH THE ARCHITECT. ADJUST NEW CONSTRUCTION AS REQUIRED.

150 W 60th St - AS-BUILTS

150 W 60th St Minneapolis, MN

B/A Project Number: 624-17

FLOOR PLAN

A201