



2828 MIDLAND MEDICAL BUILDING

2828 CHICAGO AVE SOUTH, MINNEAPOLIS, MN 55407

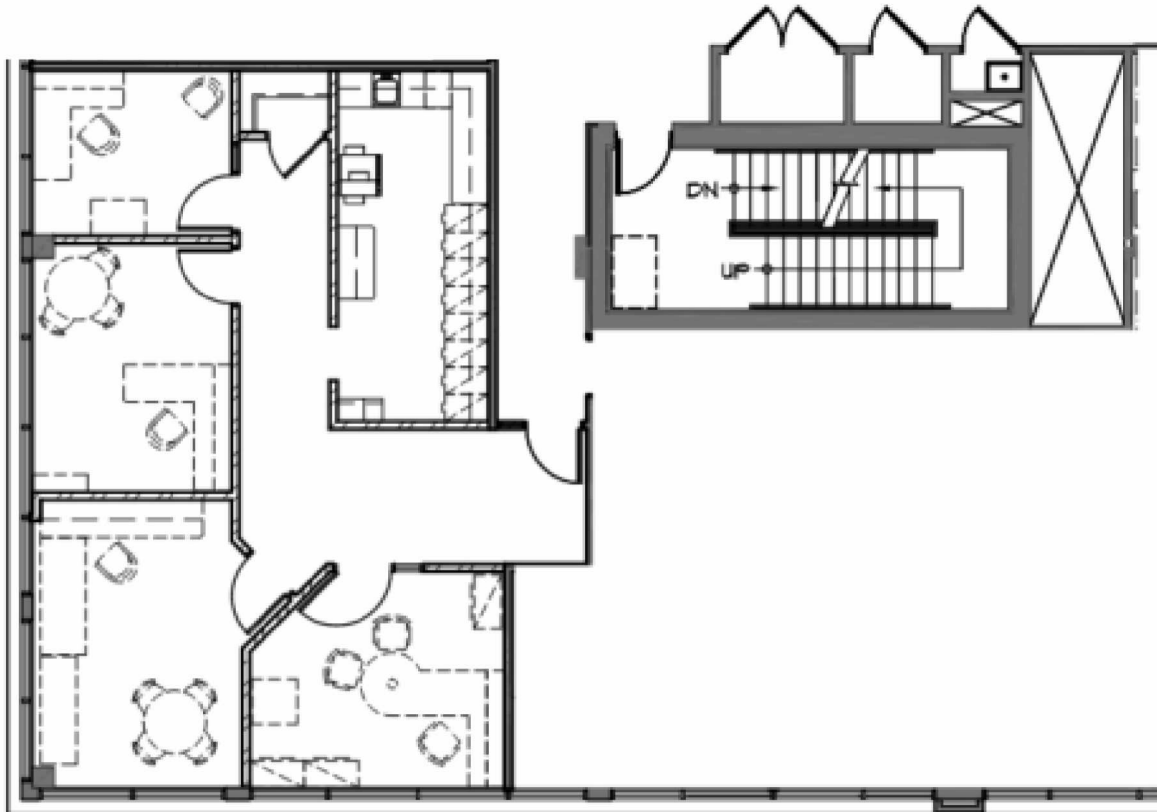

Building Key

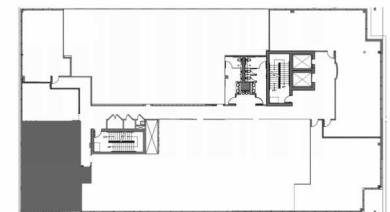

Suite: 301D

1,375 Rentable Square Feet

Mike Fleetham
952-767-2842 (direct)
612-386-0993 (mobile)
mfleetham@medcraft.com

Jolene Ludvigsen
952-838-7126 (direct)
612-889-7586 (mobile)
jludvigsen@medcraft.com

Leased by:
 **MedCraft**[®]
Healthcare Real Estate

Managed by:
 **CUSHMAN & WAKEFIELD**