


## Property Key

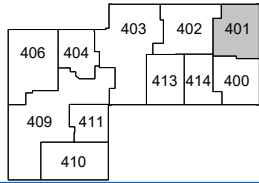


## WMG ICOT BC As Built Marketing Package

13830-13923 58th Street North, Clearwater, FL 33760

Building: 4  
Suite: 401  
Sheet: A-2


Scale: Not to Scale  
Sheet Size: 8.5" x 11"  
Not For Construction

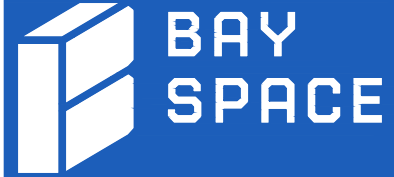

Total Area - 1,400 SF

## Building Information

DECK HEIGHT:	N/A
CEILING HEIGHT:	8'-8"
CLEAR HEIGHT:	8'-8"
SPRINKLERED:	No

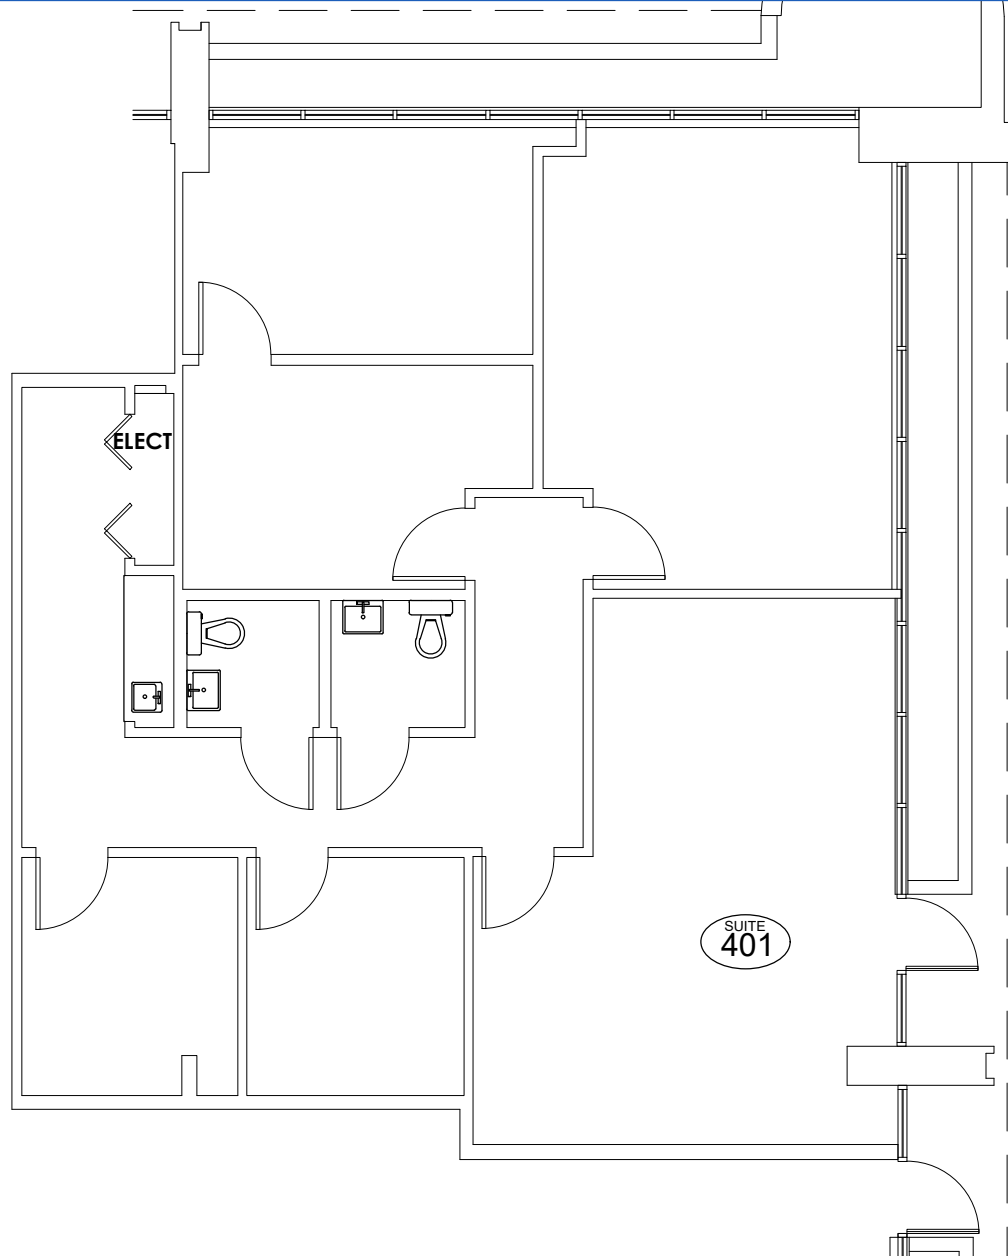

As Built Floor Plan for Marketing

