


KEY PLAN

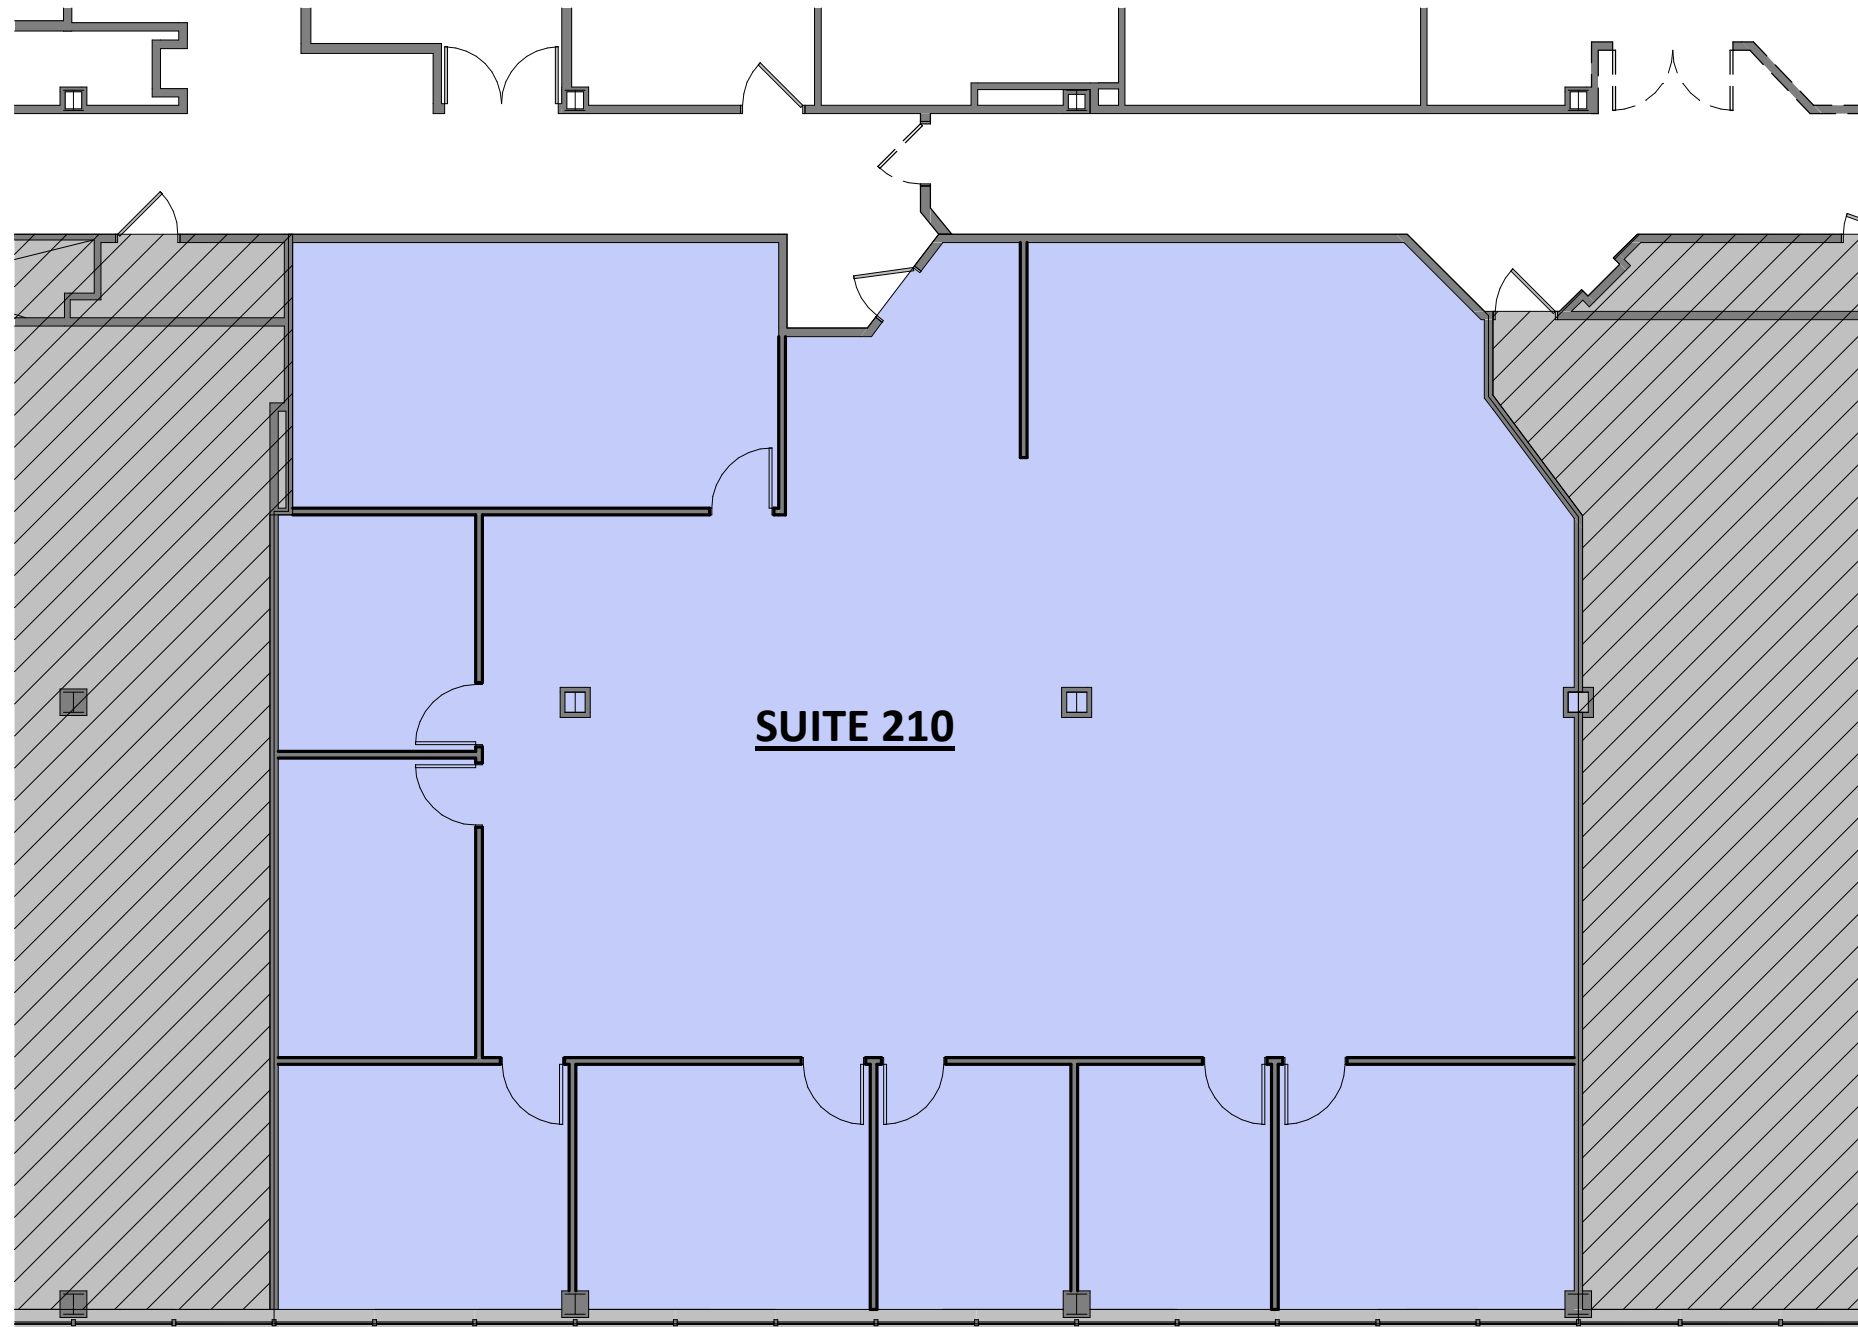

01/08/2026