


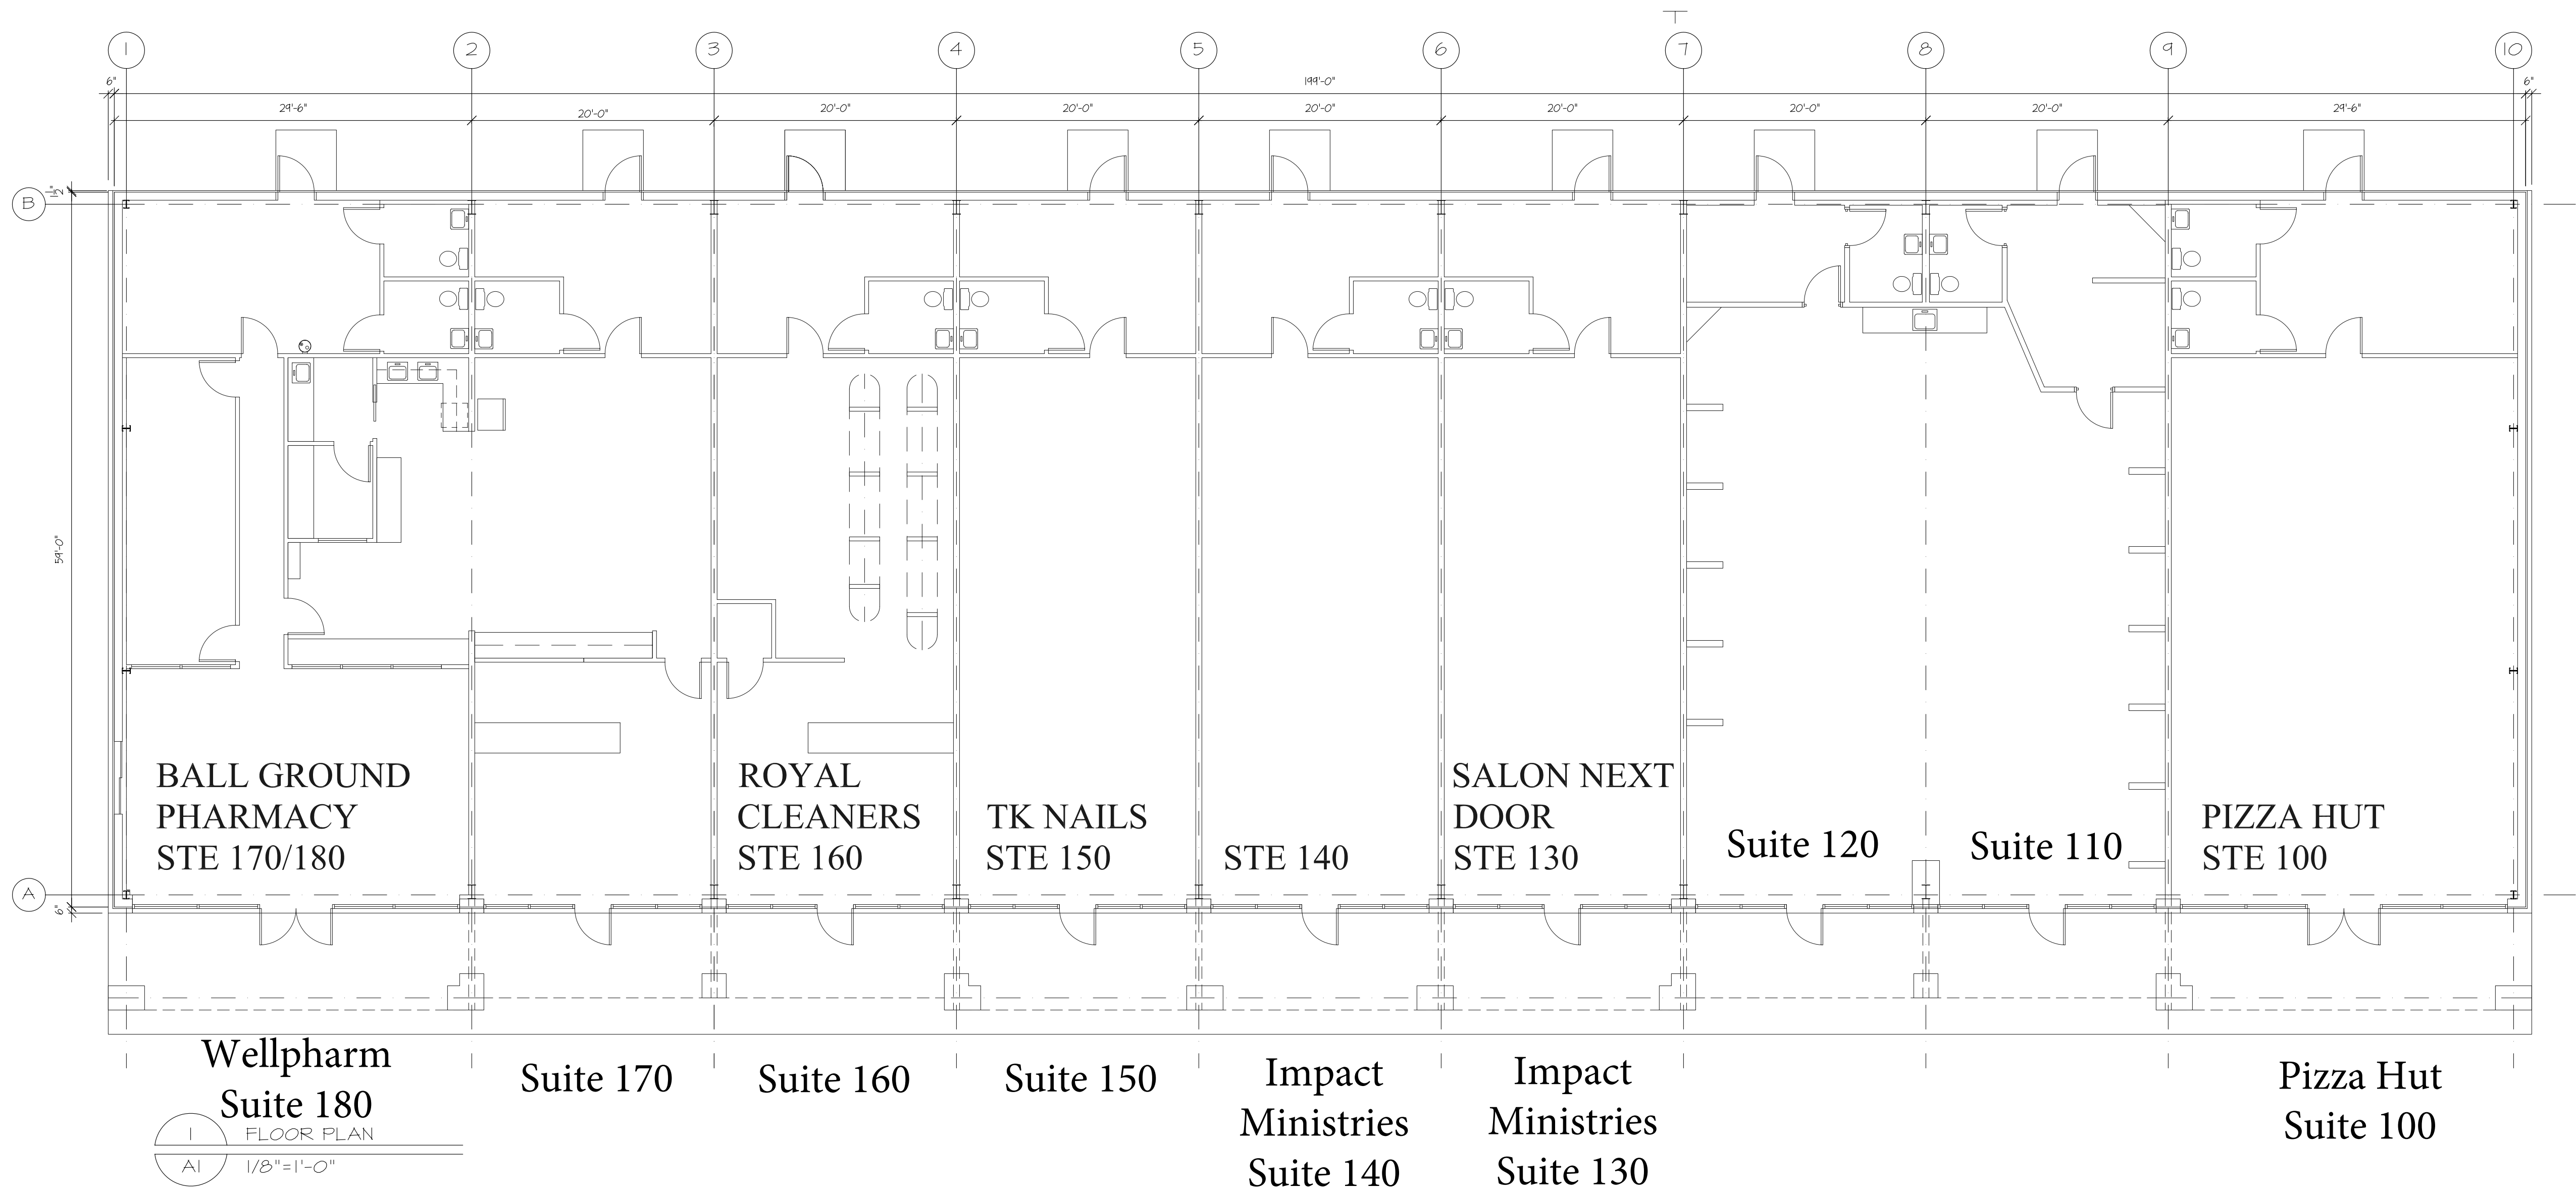

These drawings are instruments of the Architect's service for use solely with respect to this project. These drawings shall not be used by the Owner or others on other projects, additions to this project or completion of this project by others except by written agreement.

Copyright © 2001, PH&A

Project Title:
MOUNTAINBROOK RETAIL CENTER
2260 HOLLY SPRINGS PARKWAY
HOLLY SPRINGS, GEORGIA

Drawing Title:
FLOOR PLAN

Not Released for Construction Date: 23FEB/2

PH&A

Patrick Higgins & Assoc. Architects and Planners

605 Wayt Road
Roswell, Georgia 30076
(770)641-7583

Project No:

A-1

Sheet of

Revisions		